

**SURVEY & REMONUMENTATION**

**\$7.00**  
**\$2.00**  
SEP 18 1995  
COMMISSION

**KENT COUNTY REMONUMENTATION**

STATE OF MICHIGAN  
COUNTY OF KENT  
RECEIVED FOR RECORD

**LAND CORNER RECORDATION CERTIFICATE**  
Filing Requirement of Act 74, Mich. P.A. 1970

95 MAY 12 AM 10:40

For corners in  
**KENT COUNTY**

*W. J. Bond*  
REG. OF DEEDS

(County)	Located In:	Corner Code #
1. Public Land Survey	T <u>7N</u> R <u>12W</u>	D-10
	T _____ R _____	_____
	T _____ R _____	_____
	T _____ R _____	_____
2. Property Controlling in Section	S _____ T _____ R _____	_____
	S _____ T _____ R _____	_____
3. Miscellaneous Property in Sec.	S _____ T _____ R _____	_____
	S _____ T _____ R _____	_____

**8344**

Register of Deeds Stamp & File Number

4. Lot No. \_\_\_\_\_, Recorded Plat \_\_\_\_\_  
5. Private Claims \_\_\_\_\_

	A	B	C	D	E	F	G	H	I	J	K	L	M
2	6	5	4	3	2	1							
3													
4	7	8	9	10	11	12							
5													
6	18	17	16	15	14	13							
7													
8	19	20	21	22	23	24							
9													
10	30	29	28	27	26	25							
11													
12	31	32	33	34	35	36							
13													

I, Kirk Breitels, in a field survey on Nov. 15, 19 94, do hereby certify that under requirements of P.A. 74, Michigan P.A. of 1970, the corner points mentioned in lines 1 and 2 above were in conformance with regulations and rules therefore as required in the current manual of survey instructions of the United States Department of the Interior, Bureau of Land Management or by a decree of a Court of Law and/or that the corner points mentioned in lines 3, 4 and 5 above were in conformance with the rules of the Michigan Board of Land Surveyors or by a Decree of a Court of Law; established, re-established, monumented, re-monumented, recovered, found as expressed below:

**NOTE: Not more than 4 corners, all in the same town and range, may be recorded on this certificate.**

**A. Description of original monument and accessories and/or subsequent restoration:**

D-10 1837 GLO	Not Set
Kent Co. Wit.	3/4" Iron
1974 LCRC #684	Boat Spike
1977 LCRC #1033	Boat Spike
1992 LCRC #6612	Set Kent County Monument
Bonnema	
Merdzinski	
Bueche	

The position of this corner was previously approved by the Kent County Remonumentation Peer Group, monumented by John C. Bueche on 10/12/92 and was recorded per LCRC #6612

**B. Description of corner evidence found and/or method applied in restoring or reestablishing corner:**

D-10 Found standard Kent Co. Mon. (Harrison) per witnesses from above LCRC as set by John C. Bueche in place of the Boat Spike he found. Said Boat Spike checks with Kent Co. Wit. and LCRC's #684 & #1033. Said Kent Co. Mon. is 1.0' E. & 5.5' S. from true intersection of 1/4 lines.

LCRC #6613

PK W. side P. Pole	S30°E	84.85'	P.A. 345 1990 KENT COUNTY
Top C/L CP iron	N40°E	45.85'	PEER APPROVED 3/30/95
NE leg of CP tower	West	153.71'	CHAIRMAN <i>Frank Hubers</i>
NW leg of CP tower (2' above ground)	S30°W	212.33'	
Nail & KC Remon. tag E. side service pole	N30°E	113.61'	


Point is 1.07' E. of N-S 1/4 line; C/L bit. N-S is West 1' m/l

The selected location is accepted by me and is generally accepted by professional surveyors as the best available evidence of the position of the original corner.

**C. Description of monument for corner and accessories established to perpetuate locating the position of the corner:**

**D-10 Standard Kent County Monument**

PK W. side P. Pole	S30°E	84.88'	
Top C/L CP iron	N40°E	45.71'	(leaning)
NE leg of CP tower at grade	West	153.5'	
NW leg of CP tower (2' above ground)	S30°W	212.33'	
Nail & KC Remon. tag E. side service pole	N30°E	113.63'	
Top C/L hydrant	N15°W	99.82'	
Face of curb - West	14.82'	Face of curb - East	14.98'

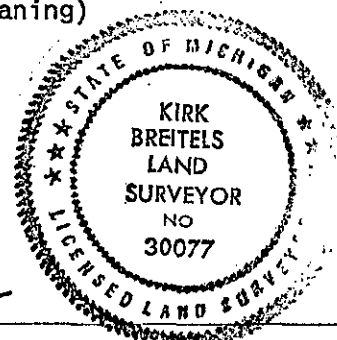

Signed by *Kirk Breitels*

Date 3/30/95

Surveyor's Michigan License No. 30077