

\$7.00  
\$2.00

JAN 24 1996

KENT COUNTY REMONUMENTATION

COMMISSION LAND CORNER RECORDATION CERTIFICATE

Filing Requirement of Act 74, Mich. P.A. 1970

For corners in  
KENT COUNTY  
(County)

Located In:

Corner Code #

1. Public Land Survey	T	7N	R	12W	D-12
	T		R		
	T		R		
	T		R		
2. Property Controlling in Section	S		R		
	S		R		
3. Miscellaneous	S		R		
Property in Section	S		R		

4. Lot No. \_\_\_\_\_, Recorded Plat \_\_\_\_\_  
5. Private Claims \_\_\_\_\_

STATE OF MICHIGAN  
COUNTY OF KENT  
RECEIVED FOR RECORD  
95 DEC 26 PM 12:43  
REG. OF DEEDS  
*Lucy Spauld*

8865

Register of Deeds Stamp & File Number

A	B	C	D	E	F	G	H	I	J	K	L	M
2	6		5		4		3		2		1	
3												
4	7		8		9		10		11		12	
5												
6	18		17		16		15		14		13	
7												
8	19		20		21		22		23		24	
9												
10	30		29		28		27		26		25	
11												
12	31		32		33		34		35		36	
13												

I, Kirk Breitels, in a field survey on Dec. 15, 1994, do hereby certify that under requirements of P.A. 74, Michigan P.A. of 1970, the corner points mentioned in lines 1 and 2 above were in conformance with regulations and rules therefore as required in the current manual of survey instructions of the United States Department of the Interior, Bureau of Land Management or by a decree of a Court of Law and/or that the corner points mentioned in lines 3, 4 and 5 above were in conformance with the rules of the Michigan Board of Professional Surveyors or by a Decree of a Court of Law; established, re-established, monumented, re-monumented, recovered, found as expressed below:

NOTE: Not more than 4 corners, all in the same town and range, may be recorded on this certificate.

A. Description of original monument and accessories and/or subsequent restoration:

D-12 1837 GLO Not Set  
1927-63 Williams & Works Iron  
Kent Co. Wit. Iron  
16" Beech SE 8.85' 12" Beech S. 14.40' 10" Elm N. 19.75'  
18" Maple E. 31.30' 14" Oak W. 28.60'

B. Description of corner evidence found and/or method applied in restoring or reestablishing corner:


D-12 Found 1 1/2" Iron Pipe inside a Well Point that fits remaining witnesses of those above. Said Iron is 3.3' S. and 1.1' E. from true intersection of 1/4 lines and fits previous survey data. Said Iron is on fence line to East and South ±.

The 1 1/2" Iron Pipe inside a Well Point is accepted by me and is generally accepted by professional surveyors as the best available evidence of the position of the corner.

P.A. 345 1990 KENT COUNTY  
PEER APPROVED 12/15/94  
CHAIRMAN *Henry Hubert*

C. Description of monument for corner and accessories established to perpetuate locating the position of the corner:

D-12 Set Standard Kent County Monument in place of the Iron & Well Point  
Set Nail & KC Remon. tag N. side 30" Beech S75°E 9.49'  
Set Nail & KC Remon. tag E. side 30" Beech S05°E 14.99'  
Set Nail & KC Remon. tag N. side 30" Oak N90°W 29.05'  
Set Nail & KC Remon. tag NW side 18" Oak N50°E 55.26'  
Set Nail & KC Remon. tag NW side 12" Oak S40°W 53.68'

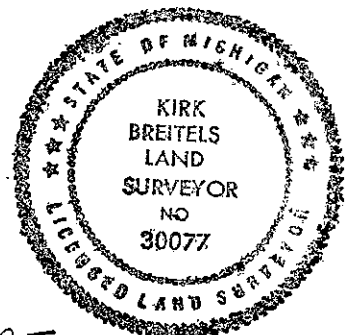

Signed by *Kirk Breitels*

Date 12/14/95

Surveyor's Michigan License No. 30077