

SURVEY & REMONUMENTATION

APR 28 1995

KENT COUNTY REMONUMENTATION

COMMISSION

LAND CORNER RECORDATION CERTIFICATE

Filing Requirement of Act 74, Mich. P.A. 1970

STATE OF MICHIGAN
COUNTY OF KENT
RECEIVED FOR RECORD

94 DEC 27 AM 9:04

W. R. Byl
REG. OF DEEDS

7894

Register of Deeds Stamp & File Number

For corners in
KENT COUNTY
(County)

Located In: Corner Code #

1. Public Land Survey	T 7N R 12W	E-2
	T R	
	T R	
	T R	
2. Property Controlling in Section	S T R	
	S T R	
3. Miscellaneous Property in Sec.	S T R	
	S T R	

4. Lot No. _____, Recorded Plat _____
5. Private Claims _____

	A	B	C	D	E	F	G	H	I	J	K	L	M
2	6		5	●	4		3		2				
3													
4	7		8		9		10		11		12		
5													
6	18		17		16		15		14		13		
7													
8	19		20		21		22		23		24		
9													
10	30		29		28		27		26		25		
11													
12	31		32		33		34		35		36		
13													

I, William R. Byl, in a field survey on Nov. 30, 19 94, do hereby certify that under requirements of P.A. 74, Michigan P.A. of 1970, the corner points mentioned in lines 1 and 2 above were in conformance with regulations and rules therefore as required in the current manual of survey instructions of the United States Department of the Interior, Bureau of Land Management or by a decree of a Court of Law and/or that the corner points mentioned in lines 3, 4 and 5 above were in conformance with the rules of the Michigan Board of Land Surveyors or by a Decree of a Court of Law, established, re-established, monumented, re-monumented, recovered, found as expressed below:

NOTE: Not more than 4 corners, all in the same town and range, may be recorded on this certificate.

A. Description of original monument and accessories and/or subsequent restoration:

E-2	1837	GLO	Whitcomb	Set Post
	1960	Kent Co. Wit.		1" Iron
	1972	LCRC #65	Spicer	1" Iron
	1977	LCRC #1080	Campbell	1/2" Iron Pipe
	1981	LCRC #1849	Tobin	Set Kent County Monument
	1990	LCRC #5531	Starr	Kent County Monument

P.A. 345 1990 KENT COUNTY
PEER APPROVED 12/22/94
CHAIRMAN *Harry Huber*

The position of this corner was previously approved by the Kent County Remonumentation Peer Group, monumented by Douglas J. Tobin on 4/1/81 and was recorded per LCRC #1849

B. Description of corner evidence found and/or method applied in restoring or reestablishing corner:


E-2 Found standard Kent Co. Mon. (Harrison) per witnesses from above LCRC as set by Douglas J. Tobin in place of the 1" Iron he found. Said 1" Iron checks with Kent Co. Wit. and LCRC's #65 & #1080.

<u>LCRC #1849</u>		<u>LCRC #5531</u>
Nail & cap 18" Hickory N	13.31'	Same witnesses as LCRC #1849-
Nail & cap 18" Cherry W	51.13'	some different measurements
Nail & cap 18" Hickory N85°W	35.55'	
Nail & cap 12" Hickory S10°E	56.83'	

The selected location is accepted by me and is generally accepted by professional surveyors as the best available evidence of the position of the original corner.

C. Description of monument for corner and accessories established to perpetuate locating the position of the corner:

E-2 Standard Kent County Monument			
Nail & KC Remon. tag W. side	22" Hickory	N00°E	13.31'
Nail & KC Remon. tag N. side	22" Cherry	S90°W	51.00'
Nail & KC Remon. tag S. side	24" Stump	N85°W	35.23'
New Nail & KC Remon. tag W. side	15" Hickory	S10°E	56.84'
Set Nail & KC Remon. tag SW side	27" Beech	S55°E	68.80'
Set Nail & KC Remon. tag NW side	22" Beech	N45°E	67.62'

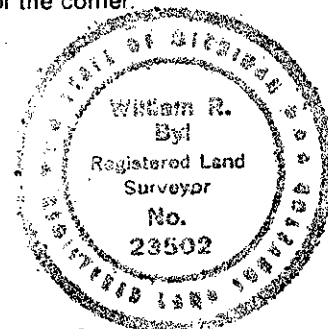

Signed by *W. R. Byl*
Surveyor's Michigan License No. 23502

Date 12/07/94