

SURVEY & REMONUMENTATION

APR 28 1995

KENT COUNTY REMONUMENTATION

STATE OF MICHIGAN
COUNTY OF KENT
RECEIVED FOR RECORD
94 NOV 28 AM 11:46

COMMISSION

LAND CORNER RECORDATION CERTIFICATE
Filing Requirement of Act 74, Mich. P.A. 1970

For corners in
KENT COUNTY
(County)

Located In: Corner Code #

- | | | |
|------------------------------------|--------------------------|-------|
| 1. Public Land Survey | T <u>7N</u> R <u>12W</u> | E-4 |
| | T _____ R _____ | _____ |
| | T _____ R _____ | _____ |
| | T _____ R _____ | _____ |
| 2. Property Controlling in Section | S _____ T _____ R _____ | _____ |
| | S _____ T _____ R _____ | _____ |
| 3. Miscellaneous Property in Sec. | S _____ T _____ R _____ | _____ |
| | S _____ T _____ R _____ | _____ |

W. R. Byl
REG. OF DEEDS

7305

Register of Deeds Stamp & File Number

4. Lot No. _____, Recorded Plat _____
5. Private Claims _____

| A | B | C | D | E | F | G | H | I | J | K | L | M |
|----|----|----|----|----|----|----|---|---|---|---|---|---|
| 2 | 6 | 5 | 4 | 3 | 2 | 1 | | | | | | |
| 3 | | | | | | | | | | | | |
| 4 | 7 | 8 | 9 | 10 | 11 | 12 | | | | | | |
| 5 | | | | | | | | | | | | |
| 6 | 18 | 17 | 16 | 15 | 14 | 13 | | | | | | |
| 7 | | | | | | | | | | | | |
| 8 | 19 | 20 | 21 | 22 | 23 | 24 | | | | | | |
| 9 | | | | | | | | | | | | |
| 10 | 30 | 29 | 28 | 27 | 26 | 25 | | | | | | |
| 11 | | | | | | | | | | | | |
| 12 | 31 | 32 | 33 | 34 | 35 | 36 | | | | | | |
| 13 | | | | | | | | | | | | |

I, William R. Byl, in a field survey on July 20, 1994, do hereby certify that under requirements of P.A. 74, Michigan P.A. of 1970, the corner points mentioned in lines 1 and 2 above were in conformance with regulations and rules therefore as required in the current manual of survey instructions of the United States Department of the Interior, Bureau of Land Management or by a decree of a Court of Law and/or that the corner points mentioned in lines 3, 4 and 5 above were in conformance with the rules of the Michigan Board of Land Surveyors or by a Decree of a Court of Law; established, re-established, monumented, re-monumented, recovered, found as expressed below:

NOTE: Not more than 4 corners, all in the same town and range, may be recorded on this certificate.

A. Description of original monument and accessories and/or subsequent restoration:

| | | | | |
|-----|------|---------------|------------|--------------------------|
| E-4 | 1837 | GLO | Whitcomb | Set Post |
| | | Kent Co. Wit. | | Stone in fence post |
| | 1974 | LCRC #663 | Spicer | 1 1/2" Iron |
| | 1977 | LCRC #980 | Bonnema | 1 1/2" Iron |
| | 1982 | LCRC #2961 | Merdzinski | Set Kent County Monument |
| | 1990 | LCRC #5533 | Starr | Kent County Monument |

The position of this corner was previously approved by the Kent County Remonumentation Peer Group, monumented by John A. Merdzinski on 3/29/82 and was recorded per LCRC #2961

B. Description of corner evidence found and/or method applied in restoring or reestablishing corner:

E-4 Found standard Kent Co. Mon. (Harrison) per witnesses from above LCRC as set by John A. Merdzinski in place of the 1 1/2" Iron he found. Said 1 1/2" Iron checks with Kent Co. Wit. and LCRC's #663 & #980

LCRC #2961

Nail & KC tag T. Pole West 103.75'
Nail & KC tag T. Pole East 3.08'
Nail & KC tag 4" Elm S30°E 12.83'
Nail & KC tag 18" Quad. Basswood North 36.42'
Corner 0.7' m/l S. Tree line E-W
On tree line N-S; Cor. 500' m/l S. RR

LCRC #5533

Nail & KC Remon. tag T. Pole West 103.75'
Nail & KC Remon. tag T. Pole East 3.08'
Nail & KC Remon. tag 18" Quad. Basswood North 36.18'
Nail & KC Remon. tag 6" Cherry South 28.24'
On tree line N-S-E-W; Corner 500' m/l S. RR

The selected location is accepted by me and is generally accepted by professional surveyors as the best available evidence of the position of the original corner.


C. Description of monument for corner and accessories established to perpetuate locating the position of the corner:

E-4 Standard Kent County Monument

| | | |
|-----------------------------------------------------|-------|--------|
| New Nail & KC Remon. tag W. side 18" Quad. Basswood | N00°E | 36.26' |
| Nail & KC Remon. tag E. side 6" Cherry | S00°E | 28.24' |
| Set Nail & KC Remon. tag NW side 8" Elm | N65°E | 39.14' |
| Set Nail & KC Remon. tag SW side 8" Elm | S30°E | 43.22' |
| On tree line N-S-E-W; Corner 500' m/l S. RR | | |

P.A. 345 1990 KENT COUNTY

PEER APPROVED 11/17/94
CHAIRMAN [Signature]

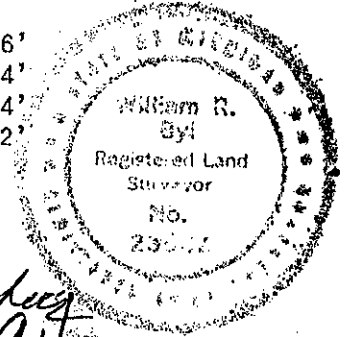

Signed by [Signature]
Surveyor's Michigan License No. 23502

Date 11-17-94