

SURVEY & REMONUMENTATION

APR 28 1995

KENT COUNTY REMONUMENTATION

COMMISSION

LAND CORNER RECORDATION CERTIFICATE
Filing Requirement of Act 74, Mich. P.A. 1970

STATE OF MICHIGAN
COUNTY OF KENT
RECEIVED FOR RECORD
94 NOV 28 AM 11:47

For corners in
KENT COUNTY
(County)

Located In:	Corner Code #
T 7N R 12W	E-6
T R	
T R	
T R	
S T R	
S T R	
S T R	
S T R	

Luigi J. Bond
REG. OF DEEDS

7307

Register of Deeds Stamp & File Number

4. Lot No. _____, Recorded Plat _____
5. Private Claims _____

	A	B	C	D	E	F	G	H	I	J	K	L	M
2	6		5		4		3		2		1		
3													
4	7		8		9		10		11		12		
5													
6	18		17		16		15		14		13		
7													
8	19		20		21		22		23		24		
9													
10	30		29		28		27		26		25		
11													
12	31		32		33		34		35		36		
13													

I, William R. Byl, in a field survey on July 20, 19 94, do hereby certify that under requirements of P.A. 74, Michigan P.A. of 1970, the corner points mentioned in lines 1 and 2 above were in conformance with regulations and rules therefore as required in the current manual of survey instructions of the United States Department of the Interior, Bureau of Land Management or by a decree of a Court of Law and/or that the corner points mentioned in lines 3, 4 and 5 above were in conformance with the rules of the Michigan Board of Land Surveyors or by a Decree of a Court of Law; established, re-established, monumented, re-monumented, recovered, found as expressed below:

NOTE: Not more than 4 corners, all in the same town and range, may be recorded on this certificate.

A. Description of original monument and accessories and/or subsequent restoration:

E-6	1837	GLO	Whitcomb	Set Post
	1879-1958	Williams & Works		Leaded Stone
		Kent Co. Wit.		Leaded Stone
	1980	LCRC #1410	VanLaar	3/4" Iron
	1984	LCRC #3858	Kolehouse	Set Kent County Monument
	1990	LCRC #5535	Starr	Kent County Monument

P.A. 345 1990 KENT COUNTY
PEER APPROVED 11/17/94
CHAIRMAN *Randy J. Kolehouse*

The position of this corner was previously approved by the Kent County Remonumentation Peer Group, monumented by Randy J. Kolehouse on 5/21/84 and was recorded per LCRC #3858

B. Description of corner evidence found and/or method applied in restoring or reestablishing corner:

E-6 Found standard Kent Co. Mon. (Harrison) per witnesses from above LCRC as set by Randy J. Kolehouse in place of the 3/4" Iron he found over a large stone. Said 3/4" Iron checks with Williams & Works information and LCRC #1410. Stone appears to be laying on its side, disturbed during road const. years ago.

LCRC #3858		LCRC #5535	
Nail & KC tag P. Pole	N10°W 25.30'	Nail & KC Remon. tag P. Pole	N10°W 25.23'
C/L str. sign post	S25°W 37.65'	C/L Street Sign Post	S25°W 38.85'
Top C/L Hydrant	S30°E 53.08'	Top C/L Hydrant	S30°E 53.17'
NE cor. CB	S50°W 36.9'	NE cor. CB	S50°W 37.04'
SE cor. CB	N60°W 36.7'	SE cor. CB	N60°W 36.75'

On C/L Bit. Rd. S-W; C/L Bit. Rd. E. is 17' S.


The selected location is accepted by me and is generally accepted by professional surveyors as the best available evidence of the position of the original corner.

C. Description of monument for corner and accessories established to perpetuate locating the position of the corner:

E-6 Standard Kent County Monument

Nail & KC Remon. tag W. side P. Pole	N10°W	25.23'
C/L Street Sign Post	S25°W	38.85'
Top C/L Hydrant	S30°E	53.14'
NE cor. CB grate	S50°W	37.04'
SE cor. CB grate	N60°W	36.75'

On C/L Bit. Rd. S-W; C/L Bit. Rd. E. is 17' S.

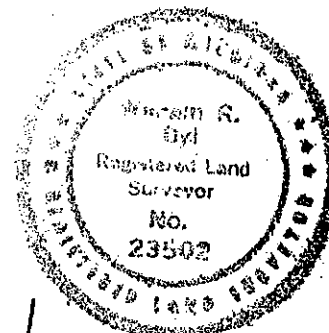

Signed by *W. R. Byl* Date 11-17-94
Surveyor's Michigan License No. 23502