

SURVEY & REMONUMENTATION

APR 28 1995

KENT COUNTY REMONUMENTATION

LAND CORNER RECORDATION CERTIFICATE
Filing Requirement of Act 74, Mich. P.A. 1970

STATE OF MICHIGAN
COUNTY OF KENT
RECEIVED FOR RECORD

94 NOV 28 AM 11:47

COMMISSION

For corners in
KENT COUNTY

(County)

Located In:

Corner Code #

1. Public Land Survey	T	7N	R	12W	E-7
	T		R		
	T		R		
	T		R		
2. Property Controlling in Section	S		T	R	
	S		T	R	
3. Miscellaneous Property in Sec.	S		T	R	
	S		T	R	


W. R. Byl
REG. OF DEEDS

7308

Register of Deeds Stamp & File Number

4. Lot No. _____, Recorded Plat _____
5. Private Claims _____

I, William R. Byl, in a field survey on July 20, 19 94, do hereby certify that under requirements of P.A. 74, Michigan P.A. of 1970, the corner points mentioned in lines 1 and 2 above were in conformance with regulations and rules therefore as required in the current manual of survey instructions of the United States Department of the Interior, Bureau of Land Management or by a decree of a Court of Law and/or that the corner points mentioned in lines 3, 4 and 5 above were in conformance with the rules of the Michigan Board of Land Surveyors or by a Decree of a Court of Law; established, re-established, monumented, re-monumented, recovered, found as expressed below:

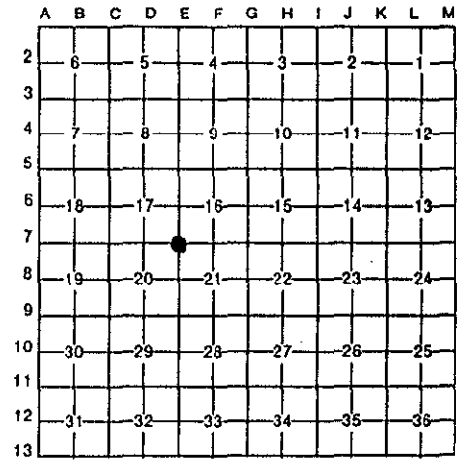

NOTE: Not more than 4 corners, all in the same town and range, may be recorded on this certificate.

A. Description of original monument and accessories and/or subsequent restoration:

E-7	1837	GLO	Whitcomb	Set Post
	1935	Kent Co. Wit.		Mon. Box
	1980	LCRC #1410	VanLaar	Mon. Box
	1981	LCRC #1843	Shangraw	Set Kent County Monument
	1990	LCRC #5536	Starr	Kent County Monument

P.A. 345 1990 KENT COUNTY
PEER APPROVED 11/17/94
CHAIRMAN *Henry Stuber*

The position of this corner was previously approved by the Kent County Remonumentation Peer Group, monumented by Carl F. Shangraw on 5/22/81 and was recorded per LCRC #1843

B. Description of corner evidence found and/or method applied in restoring or reestablishing corner:

E-7 Found standard Kent Co. Mon. (Harrison) per witnesses from above LCRC as set by Carl F. Shangraw in place of the 1/2" he found in a Mon Box. Said 1/2" Iron in Mon. box checks with Kent Co. Wit. and LCRC #1410.

<u>LCRC #1843</u>	<u>LCRC #5536</u>
NE cor. top step walk S42°W 51.00'	NE cor. top step walk to hse. S42°W 51.00'
KC Nail & tag 8" Cedar N33°E 82.97'	SE cor. 2.2'x 2.2' conc. sign base N52°W 62.25'
SE cor. 2.2'x 2.2' conc. sign base N52°W 62.25'	Center of hydrant NW 50.75'
Center of hydrant NW 50.75'	Nail & KC Remon. tag Tele. Pole S30°E 33.47'
	Nail & KC Remon. tag P. Pole N20°E 53.59'
	On C/L Bit. Rd. E-W-N

The selected location is accepted by me and is generally accepted by professional surveyors as the best available evidence of the position of the original corner.

C. Description of monument for corner and accessories established to perpetuate locating the position of the corner:

E-7 Standard Kent County Monument	
NE cor. top step conc. walk to hse.	S42°W 50.93'
SE cor. 2.2'x 2.2' conc. sign base	N52°W 62.25'
Center of hydrant	N25°W 50.75'
Nail & KC Remon. tag E. side Lt. Pole	S30°E 33.47'
Nail & KC Remon. tag E. side P. Pole	N20°E 53.59'
On C/L Bit. Rd. E-W-N	



Signed by *W. R. Byl* Date 11-17-94
Surveyor's Michigan License No. 23502