

SURVEY & REMONUMENTATION

APR 28 1995

COMMISSION

KENT COUNTY REMONUMENTATION

LAND CORNER RECORDATION CERTIFICATE
Filing Requirement of Act 74, Mich. P.A. 1970

STATE OF MICHIGAN
COUNTY OF KENT
RECEIVED FOR RECORD

94 NOV 28 AM 11:47

For corners in
KENT COUNTY
(County)

Located In:

Corner Code -#

- | | | |
|------------------------------------|--------------------------|-------|
| 1. Public Land Survey | T <u>7N</u> R <u>12W</u> | E-8 |
| | T _____ R _____ | _____ |
| | T _____ R _____ | _____ |
| | T _____ R _____ | _____ |
| 2. Property Controlling in Section | S _____ T _____ R _____ | _____ |
| | S _____ T _____ R _____ | _____ |
| 3. Miscellaneous Property in Sec. | S _____ T _____ R _____ | _____ |
| | S _____ T _____ R _____ | _____ |

W. J. Bond
REG. OF DEEDS

7309

Register of Deeds Stamp & File Number

4. Lot No. _____, Recorded Plat _____
5. Private Claims _____

A	B	C	D	E	F	G	H	I	J	K	L	M
2	6	5	4	3	2	1						
3												
4	7	8	9	10	11	12						
5												
6	18	17	16	15	14	13						
7												
8	19	20	21	22	23	24						
9												
10	30	29	28	27	26	25						
11												
12	31	32	33	34	35	36						
13												

I, William R. Byl, in a field survey on June 20, 19 94, do hereby certify that under requirements of P.A. 74, Michigan P.A. of 1970, the corner points mentioned in lines 1 and 2 above were in conformance with regulations and rules therefore as required in the current manual of survey instructions of the United States Department of the Interior, Bureau of Land Management or by a decree of a Court of Law and/or that the corner points mentioned in lines 3, 4 and 5 above were in conformance with the rules of the Michigan Board of Land Surveyors or by a Decree of a Court of Law; established, re-established, monumented, re-monumented, recovered, found as expressed below:

NOTE: Not more than 4 corners, all in the same town and range, may be recorded on this certificate.

A. Description of original monument and accessories and/or subsequent restoration:

E-8	1837	GLO	Whitcomb	Set Post
	1957, 1959	Kent Co. Wit.		1" Iron
	1972	LCRC #352	Spicer	1" Iron
	1983	LCRC #3314	Tobin	Set Kent County Monument
	1990	LCRC #5537	Starr	Kent County Monument

P.A. 345 1990 KENT COUNTY
PEER APPROVED 11/17/94
CHAIRMAN *Harold Huber*

The position of this corner was previously approved by the Kent County Remonumentation Peer Group, monumented by Douglas J. Tobin on 5/22/82 and recorded per LCRC #3314

B. Description of corner evidence found and/or method applied in restoring or reestablishing corner:


E-8 Found standard Kent Co. Mon. (Harrison) per witnesses from above LCRC as set by Douglas J. Tobin in place of the 1" Iron he found. Said 1" Iron checks with Kent Co. Wit. and LCRC #352.

<u>LCRC #3314</u>		<u>LCRC #5537</u>	
KC Tag & Nail 10" Maple	N20°E 44.71'	Nail & KC Remon. tag 8" Ash	S50°W 32.68'
KC Tag & Nail 8" Maple	S40°E 60.65'	Nail & KC Remon. tag 16" Oak	N80°W 34.55'
KC Tag & Nail Tw. 8" Ash	S50°W 32.65'	Nail & KC Remon. tag P. Pole	N20°E 81.74'
		Nail & KC Remon. tag P. Pole	S15°E 108.51'
		Top C/L Fire Hydrant	S75°E 19.39'

The selected location is accepted by me and is generally accepted by professional surveyors as the best available evidence of the position of the original corner.

C. Description of monument for corner and accessories established to perpetuate locating the position of the corner:

E-8 Standard Kent County Monument			
New Nail & KC Remon. tag S. side 10" Ash	S50°W	32.67'	
New Nail & KC Remon. tag S. side 18" Oak	N80°W	34.45'	
Nail & KC Remon. tag W. side P. Pole	N20°E	81.70'	
Nail & KC Remon. tag W. side P. Pole	S15°E	108.42'	
Top C/L Fire Hydrant	S75°E	19.27'	

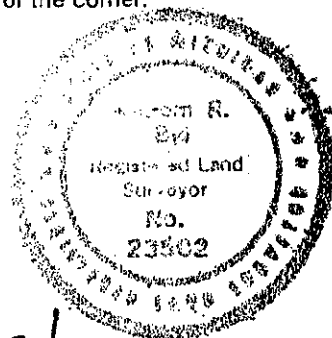

Signed by *W. R. Byl* Date 11-17-94
Surveyor's Michigan License No. 23502