

SURVEY & REMONUMENTATION

APR 28 1995

KENT COUNTY REMONUMENTATION

COMMISSION

LAND CORNER RECORDATION CERTIFICATE
Filing Requirement of Act 74, Mich. P.A. 1970

STATE OF MICHIGAN
COUNTY OF KENT
RECEIVED FOR RECORD

94 NOV 28 AM 11:47

For corners in
KENT COUNTY
(County)

Located In:

Corner Code #

- 1. Public Land Survey T 7N R 12W
- 2. Property Controlling in Section S T R
- 3. Miscellaneous Property in Sec. S T R

E-10

W. J. Byl
REG. OF DEEDS

7311

Register of Deeds Stamp & File Number

- 4. Lot No. _____, Recorded Plat _____
- 5. Private Claims _____

	A	B	C	D	E	F	G	H	I	J	K	L	M
2	6		5		4		3		2		1		
3													
4	7		8		9		10		11		12		
5													
6	18		17		16		15		14		13		
7													
8	19		20		21		22		23		24		
9													
10	30		29		28		27		26		25		
11													
12	31		32		33		34		35		36		
13													

I, William R. Byl, in a field survey on July 1, 19 94, do hereby certify that under requirements of P.A. 74, Michigan P.A. of 1970, the corner points mentioned in lines 1 and 2 above were in conformance with regulations and rules therefore as required in the current manual of survey instructions of the United States Department of the Interior, Bureau of Land Management or by a decree of a Court of Law and/or that the corner points mentioned in lines 3, 4 and 5 above were in conformance with the rules of the Michigan Board of Land Surveyors or by a Decree of a Court of Law; established, re-established, monumented, re-monumented, recovered, found as expressed below:

NOTE: Not more than 4 corners, all in the same town and range, may be recorded on this certificate.

A. Description of original monument and accessories and/or subsequent restoration:

E-10	1837	GLO	Whitcomb	Set Post
		Kent Co. Wit.		Round Iron top of Square Iron
	1977	LCRC #1033	Merdzinski	1" Iron
	1983	LCRC #3315	Tobin	Set Kent County Monument
	1990	LCRC #5539	Starr	Kent County Monument

The position of this corner was previously approved by the Kent County Remonumentation Peer Group, monumented by Douglas J. Tobin on 5/21/82 and was recorded per LCRC #3315

B. Description of corner evidence found and/or method applied in restoring or reestablishing corner:

E-10 Found standard Kent Co. Mon. (Harrison) per witnesses from above LCRC as set by Douglas J. Tobin in place of the 1" Iron he found. Said 1" Iron checks with Kent Co. Wit. and LCRC #1033.

<u>LCRC #3315</u>		<u>LCRC #5539</u>	
KC Nail & tag 16" Maple	N40°W 37.25'	Nail & KC Remon. tag 16" Maple	N40°W 37.45'
KC nail & tag 26" Maple	N20°W 88.35'	Nail & KC Remon. tag 26" Maple	N20°W 88.35'
SW leg of tower	East 43.25'	SW leg of tower	East 43.25'
NE leg of tower	S45°E 92.00'	NE leg of tower	S45°E 92.00'

C/L of N-S Bit. Rd. is 3.5' E.
On line with N. set of CP tower line


The selected location is accepted by me and is generally accepted by professional surveyors as the best available evidence of the position of the original corner.

C. Description of monument for corner and accessories established to perpetuate locating the position of the corner:

E-10 Standard Kent County Monument	
New Nail & KC Remon. tag SW side 20" Maple	N40°W 37.41'
New Nail & KC Remon. tag E. side 30" Maple	N20°W 88.29'
SW leg of tower	S90°E 43.25'
NE leg of tower	S45°E 92.00'
C/L of N-S Bit. Rd. is 3.5' E.	

On line with N. set of CP tower line
P.A. 345 1990 KENT COUNTY

PEER APPROVED 11/17/94
CHAIRMAN Henry Hudson

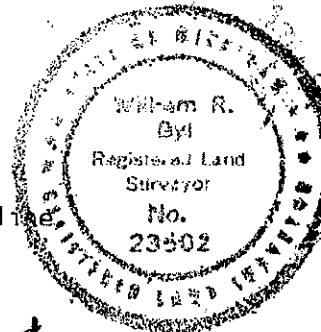

Signed by W. R. Byl Date 11-17-94
Surveyor's Michigan License No. 23502