

SURVEY & REMONUMENTATION

KENT COUNTY REMONUMENTATION

APR 28 1995

LAND CORNER RECORDATION CERTIFICATE
Filing Requirement of Act 74, Mich. P.A. 1970

STATE OF MICHIGAN
COUNTY OF KENT
RECEIVED FOR RECORD
94 NOV 28 AM 11:47

For corner **COMMISSION**
KENT COUNTY
(County)

Located In: Corner Code =#

1. Public Land Survey	T <u>7N</u> R <u>12W</u>	<u>F-7</u>
	T _____ R _____	_____
	T _____ R _____	_____
	T _____ R _____	_____
2. Property Controlling in Section	S _____ T _____ R _____	_____
	S _____ T _____ R _____	_____
3. Miscellaneous Property in Sec.	S _____ T _____ R _____	_____
	S _____ T _____ R _____	_____

W. R. Dyl
REG. OF DEEDS


7315

Register of Deeds Stamp & File Number

4. Lot No. _____, Recorded Plat _____
5. Private Claims _____

I, William R. Dyl, in a field survey on July 19, 19 94, do hereby certify that under requirements of P.A. 74, Michigan P.A. of 1970, the corner points mentioned in lines 1 and 2 above were in conformance with regulations and rules therefore as required in the current manual of survey instructions of the United States Department of the Interior, Bureau of Land Management or by a decree of a Court of Law and/or that the corner points mentioned in lines 3, 4 and 5 above were in conformance with the rules of the Michigan Board of Land Surveyors or by a Decree of a Court of Law; established, re-established, monumented, re-monumented, recovered, found as expressed below:

NOTE: Not more than 4 corners, all in the same town and range, may be recorded on this certificate.

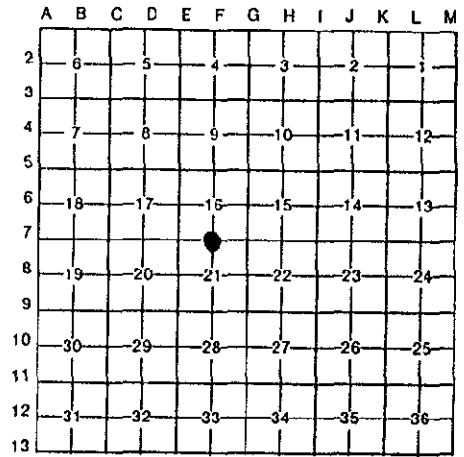

A. Description of original monument and accessories and/or subsequent restoration:

F-7	1837	GLO	Whitcomb	Set Post
	1941	Kent Co. Wit.		Mon. Box
	1974	LCRC #724	VanKooten	Iron
	1982	LCRC #2965	Merdzinski	Set Kent County Monument
	1990	LCRC #5545	Starr	Kent County Monument

P.A. 345 1990 KENT COUNTY

PEER APPROVED 11/17/94
CHAIRMAN *Harry Huber*

The position of this corner was previously approved by the Kent County Remonumentation Peer Group, monumented by John A. Merdzinski on 3/29/82 and was recorded per LCRC #2965

B. Description of corner evidence found and/or method applied in restoring or reestablishing corner:

F-7 Found standard Kent Co. Mon. (Harrison) per witnesses from above LCRC as set by John A. Merdzinski in place of the 3/4" Iron he found in a Mon. Box. Said 3/4" Iron in Mon. Box checks with Kent Co. Wit. and LCRC #724.


<u>LCRC #2965</u>		<u>LCRC #5545</u>	
Top C/L hydrant	S40°W 45.06'	same witnesses as LCRC #2965	
Top C/L hydrant	S20°E 82.43'		
Nail & KC tag P. Pole	S60°E 50.39'		
Nail & KC tag P. Pole	N25°W 58.85'		
NW cor. brick pillar	N40°E 80.40'		
Cor. on C/L Rd. S.			
C/L Rd. E-W is 16.5' N.			

The selected location is accepted by me and is generally accepted by professional surveyors as the best available evidence of the position of the original corner.

C. Description of monument for corner and accessories established to perpetuate locating the position of the corner:

F-7 Standard Kent County Monument

Top C/L hydrant	S40°W 45.06'
Top C/L hydrant	S20°E 82.37'
Nail & KC Remon. tag SW side P. Pole	S60°E 50.31'
Nail & KC Remon. tag E. side P. Pole	N25°W 58.85'
NW cor. brick pillar	N40°E 80.35'
Corner on C/L Rd. S.	
C/L Rd. E-W is 16.5' N.	

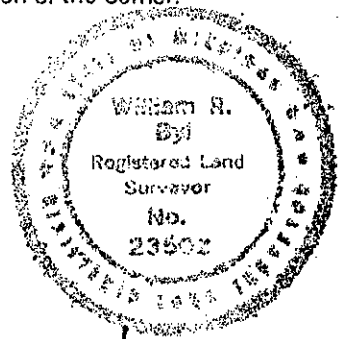

Signed by *W. R. Dyl*
Surveyor's Michigan License No. 23502

Date 11-17-94