

SURVEY & DOCUMENTATION

\$7.00  
\$2.00

JAN 24 1996

KENT COUNTY REMONUMENTATION

COMMISSION

LAND CORNER RECORDATION CERTIFICATE  
Filing Requirement of Act 74, Mich. P.A. 1970

For corners in  
KENT COUNTY  
(County)

Located In:

Corner Code #

- 1. Public Land Survey      T 7N R 12W      F-8
- T    R
- T    R
- T    R
- 2. Property Controlling    S    T    R
- in Section               S    T    R
- 3. Miscellaneous           S    T    R
- Property in Section     S    T    R

STATE OF MICHIGAN  
COUNTY OF KENT  
RECEIVED FOR RECORD  
95 DEC 26 PM 12:43  
REG. OF DEEDS  
*David Spauld*

8855

Register of Deeds Stamp & File Number

- 4. Lot No. \_\_\_\_\_, Recorded Plat \_\_\_\_\_
- 5. Private Claims \_\_\_\_\_

I, Kirk Breitels, in a field survey on Nov. 15, 19 94, do hereby certify that under requirements of P.A. 74, Michigan P.A. of 1970, the corner points mentioned in lines 1 and 2 above were in conformance with regulations and rules therefore as required in the current manual of survey instructions of the United States Department of the Interior, Bureau of Land Management or by a decree of a Court of Law and/or that the corner points mentioned in lines 3, 4 and 5 above were in conformance with the rules of the Michigan Board of Professional Surveyors or by a Decree of a Court of Law; established, re-established, monumented, re-monumented, recovered, found as expressed below:

A	B	C	D	E	F	G	H	I	J	K	L	M
2	6	5	4	3	2	1						
3												
4	7	8	9	10	11	12						
5												
6	18	17	16	15	14	13						
7												
8	19	20	21	22	23	24						
9												
10	30	29	28	27	26	25						
11												
12	31	32	33	34	35	36						
13												

NOTE: Not more than 4 corners, all in the same town and range, may be recorded on this certificate.

A. Description of original monument and accessories and/or subsequent restoration:

- F-8 1837 GLO Not Set 1929-67 Williams & Works Iron - Conc. Mon. - Boat Spike  
Plat Mon. SE 46.9' Plat Mon. NE 46.0'  
8" Ash W. 23.4' 6" Elm NW 36.9'
- 1941 Kent Co. Wit. 1" Iron  
Conc. Mon. SE 46.65' Conc. Mon. NE 46.0' 6" Elm NW 36.7'  
8" Pignut W. 23.3' 6" Pear NE 57.3' CP Pole NW 34.85'
- 1980 LCRC #1397 Merdzinski 1/2" Iron  
Top hydr. S30°W 42.78' SE cor. brk. gar. N70°W 75.83'  
SW cor. brk. gar. N45°E 89.90' Guy Pole S45°E 46.85'

B. Description of corner evidence found and/or method applied in restoring or reestablishing corner:


F-8 Found 1/2" Rerod that fits remaining witnesses of those above and agrees with previous survey data. Said 1/2" Rerod is 1.7' E. & 0.4' S. from true intersection of 1/4 lines.

The 1/2" Rerod is accepted by me and is generally accepted by professional surveyors as the best available evidence of the position of the corner.

P.A. 345 1990 KENT COUNTY  
PEER APPROVED 11/17/94  
CHAIRMAN Harry Huber

C. Description of monument for corner and accessories established to perpetuate locating the position of the corner:

- F-8 Set Standard Kent County Monument in place of the 1/2" Rerod
- Top C/L fire hydrant S30°W 44.51'
- SE corner brick garage N70°W 75.75'
- SW corner brick garage N45°E 89.84'
- Concrete Monument N45°E 46.12'
- Angle Iron S45°E 47.19'

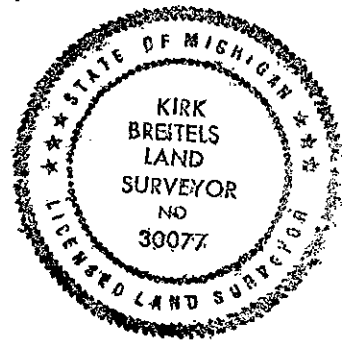

Signed by Kirk Breitels

Date 12/14/95

Surveyor's Michigan License No. 30077