

SURVEY & REMONUMENTATION

KENT COUNTY REMONUMENTATION

APR 28 1995

LAND CORNER RECORDATION CERTIFICATE
Filing Requirement of Act 74, Mich. P.A. 1970

For corners in **COMMISSION**
KENT COUNTY

STATE OF MICHIGAN
COUNTY OF KENT
RECEIVED FOR RECORD
94 NOV 28 AM 11:47

Lucy Bond
REG. OF DEEDS

(County)	Located In:	Corner Code -#
1. Public Land Survey	T <u>7N</u> R <u>12W</u>	<u>F-9</u>
	T _____ R _____	_____
	T _____ R _____	_____
	T _____ R _____	_____
2. Property Controlling in Section	S _____ T _____ R _____	_____
	S _____ T _____ R _____	_____
3. Miscellaneous Property in Sec.	S _____ T _____ R _____	_____
	S _____ T _____ R _____	_____

7316
Register of Deeds Stamp & File Number

4. Lot No. _____, Recorded Plat _____
5. Private Claims _____

	A	B	C	D	E	F	G	H	I	J	K	L	M
2	6	5	4	3	2	1							
3													
4	7	8	9	10	11	12							
5													
6	18	17	16	15	14	13							
7													
8	19	20	21	22	23	24							
9													
10	30	29	28	27	26	25							
11													
12	31	32	33	34	35	36							
13													

I, William R. Byl, in a field survey on July 22, 1994, do hereby certify that under requirements of P.A. 74, Michigan P.A. of 1970, the corner points mentioned in lines 1 and 2 above were in conformance with regulations and rules therefore as required in the current manual of survey instructions of the United States Department of the Interior, Bureau of Land Management or by a decree of a Court of Law and/or that the corner points mentioned in lines 3, 4 and 5 above were in conformance with the rules of the Michigan Board of Land Surveyors or by a Decree of a Court of Law; established, re-established, monumented, re-monumented, recovered, found as expressed below:

NOTE: Not more than 4 corners, all in the same town and range, may be recorded on this certificate.

A. Description of original monument and accessories and/or subsequent restoration:

Corner Code	Date	Agency/Person	Monument Type
F-9	1837	GLO	Whitcomb Set Post
	1941	Kent Co. Wit.	Mon. Box
	1970	Williams & Works	Mon. Box
	1983	LCRC #3300	Glaza 1" Iron in Mon. Box
	1983	LCRC #3508	Byl Set Kent County Monument
	1990	LCRC #5546	Starr Kent County Monument

P.A. 345 1990 KENT COUNTY
PEER APPROVED 11/17/94
CHAIRMAN *[Signature]*

The position of this corner was previously approved by the Kent County Remonumentation Peer Group, monumented by William R. Byl on 7/27/83 and was recorded per LCRC #3508

B. Description of corner evidence found and/or method applied in restoring or reestablishing corner:

F-9 Found standard Kent Co. Mon. (Harrison) per witnesses from above LCRC as set by William R. Byl in place of the 3/4" Solid Rod he found in a Mon. Boc. Said 3/4" Solid Rod in Mon. Box checks with Kent Co. Wit., Williams & Works Notes, and LCRC #3300.


LCRC #3508	LCRC #5546
Nail & tag P. Pole S55°W 52.35'	same witnesses as LCRC #3508
Nail & tag P. Pole N35°E 55.92'	
C/L top of hydrant N20°W 63.50'	
C/L N'yly MBT MH S35°E 55.75'	

The selected location is accepted by me and is generally accepted by professional surveyors as the best available evidence of the position of the original corner.

C. Description of monument for corner and accessories established to perpetuate locating the position of the corner:

F-9 Standard Kent County Monument

Nail & KC Remon. tag N. side P. Pole	S55°W	52.35'
Nail & KC Remon. tag W. side P. Pole	N35°E	55.92'
C/L top of hydrant	N20°W	63.56'
C/L Notherly MBT manhole	S35°E	55.75'
On C/L Bit. Rd. N-S-E-W		

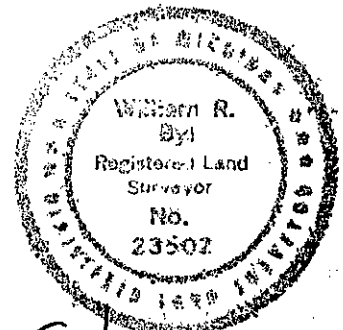

Signed by *W. R. Byl*
Surveyor's Michigan License No. 23502

Date 11-17-94