

SURVEY & RE-MONUMENTATION

\$7.00
\$2.00

JAN 24 1996

KENT COUNTY REMONUMENTATION

COMMISSION LAND CORNER RECORDATION CERTIFICATE
Filing Requirement of Act 74, Mich. P.A. 1970

For corners in
KENT COUNTY
(County)

Located In:

Corner Code #

1. Public Land Survey	T	<u>7N</u>	R	<u>12W</u>	<u>F-10</u>
	T		R		
	T		R		
	T		R		
2. Property Controlling in Section	S		T	R	
	S		T	R	
3. Miscellaneous Property in Section	S		T	R	
	S		T	R	

STATE OF MICHIGAN
COUNTY OF KENT
RECEIVED FOR RECORD
95 DEC 26 PM 12:43
REG. OF DEEDS
Lucy Spindel

8862

Register of Deeds Stamp & File Number

- 4. Lot No. _____, Recorded Plat _____
- 5. Private Claims _____

A	B	C	D	E	F	G	H	I	J	K	L	M
2	6		5		4		3		2		1	
3												
4	7		8		0		10		11		12	
5												
6	18		17		16		15		14		13	
7												
8	19		20		21		22		23		24	
9												
10	30		29		28		27		26		25	
11												
12	31		32		33		34		35		36	
13												

I, Kirk Breitels, in a field survey on Nov. 15, 19 94, do hereby certify that under requirements of P.A. 74, Michigan P.A. of 1970, the corner points mentioned in lines 1 and 2 above were in conformance with regulations and rules therefore as required in the current manual of survey instructions of the United States Department of the Interior, Bureau of Land Management or by a decree of a Court of Law and/or that the corner points mentioned in lines 3, 4 and 5 above were in conformance with the rules of the Michigan Board of Professional Surveyors or by a Decree of a Court of Law; established, re-established, monumented, re-monumented, recovered, found as expressed below:

NOTE: Not more than 4 corners, all in the same town and range, may be recorded on this certificate.

A. Description of original monument and accessories and/or subsequent restoration:

F-10 1837 GLO Not Set
 1913-86 Williams & Works Set at "X" 1/4 lines - Conc. Mon. - Set Iron
 30" Oak NE 94.20' CP Iron NE 45.65'
 CP Iron NW 47.80' SW leg tower ESE 46.60' 18" Elm NW 94.30'
 1972 LCRC #283 VanKooten Iron
 SW leg tower ESE 46.60' 16" Apple ENE 48.41'
 14" Apple NE 68.0' T. Pole SSE 162.45'
 Exxel Eng. Rerod per LCRC #283 + additional witnesses
 C/L MH S. 89.62' "X" top culv. SE 44.11' "X" top culv. ENE 19.57'

B. Description of corner evidence found and/or method applied in restoring or reestablishing corner:


F-10 Found Rerod that fits the remaining witnesses of those above. Said Rerod is 25.8' S. & 0.2' E. from the true intersection of 1/4 lines and agrees with survey data of others.

The Rerod is accepted by me and is generally accepted by professional surveyors as the best available evidence of the position of the corner.

P.A. 345 1990 KENT COUNTY
PEER APPROVED 11/17/94
CHAIRMAN *Harry Huber*

C. Description of monument for corner and accessories established to perpetuate locating the position of the corner:

F-10 Set Standard Kent County Monument in place of the Rerod.
 Set Nail & KC Remon. tag W. side Lt. Pole S15°E 162.58'
 Set Nail & KC Remon. tag SE side 10" Pine S45°E 41.87'
 Set Nail & KC Remon. tag SW side 10" Pine N40°W 45.29'
 Center of manhole S00°E 89.62'
 "X" top 12" conc. culv. S25°E 44.11'
 "X" top 12" conc. culv. N85°E 19.57'
 SW leg of CP tower S80°E 46.60'

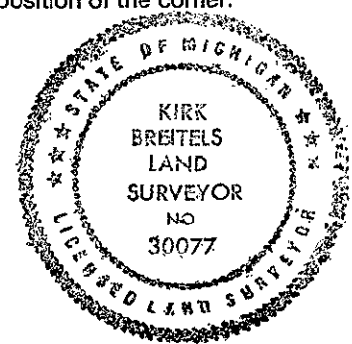

Signed by *Kirk Breitels*

Date 12/14/95

Surveyor's Michigan License No. 30077