

SURVEY & REMONUMENTATION

KENT COUNTY REMONUMENTATION

APR 28 1995

LAND CORNER RECORDATION CERTIFICATE
Filing Requirement of Act 74, Mich. P.A. 1970

COMMISSION

For corners in
KENT COUNTY

(County)	Located In:	Corner Code =#
1. Public Land Survey	T <u>7N</u> R <u>12W</u>	<u>F-11</u>
	T _____ R _____	_____
	T _____ R _____	_____
	T _____ R _____	_____
2. Property Controlling in Section	S _____ T _____ R _____	_____
	S _____ T _____ R _____	_____
3. Miscellaneous Property in Sec.	S _____ T _____ R _____	_____
	S _____ T _____ R _____	_____

STATE OF MICHIGAN
COUNTY OF KENT
RECEIVED FOR RECORD
94 NOV 28 AM 11:47

Lucy J. Bond
REG. OF DEEDS

7317

Register of Deeds Stamp & File Number

- 4. Lot No. _____, Recorded Plat _____
- 5. Private Claims _____

	A	B	C	D	E	F	G	H	I	J	K	L	M
2	6	5	4	3	2	1							
3													
4	7	8	9	10	11	12							
5													
6	18	17	16	15	14	13							
7													
8	19	20	21	22	23	24							
9													
10	30	29	28	27	26	25							
11													
12	31	32	33	34	35	36							
13													

I, William R. Byl, in a field survey on June 30, 19 94, do hereby certify that under requirements of P.A. 74, Michigan P.A. of 1970, the corner points mentioned in lines 1 and 2 above were in conformance with regulations and rules therefore as required in the current manual of survey instructions of the United States Department of the Interior, Bureau of Land Management or by a decree of a Court of Law and/or that the corner points mentioned in lines 3, 4 and 5 above were in conformance with the rules of the Michigan Board of Land Surveyors or by a Decree of a Court of Law; established, re-established, monumented, re-monumented, recovered, found as expressed below:

NOTE: Not more than 4 corners, all in the same town and range, may be recorded on this certificate.

A. Description of original monument and accessories and/or subsequent restoration:

F-11	1837	GLO	Whitcomb	Set Post
		Kent Co. Wit.		Mon. Box
	1973	LCRC #283	VanKooten	Iron
	1982	LCRC #2788	Merdzinski	Set Kent County Monument
	1990	LCRC #5547	Starr	Kent County Monument

P.A. 345 1990 KENT COUNTY
PEER APPROVED 11/17/94
CHAIRMAN *Harry Huber*

The position of this corner was previously approved by the Kent County Remonumentation Peer Group, monumented by John A. Merdzinski on 3/23/82 and was recorded per LCRC #2788

B. Description of corner evidence found and/or method applied in restoring or reestablishing corner:


F-11 Found standard Kent Co. Mon. (Harrison) per witnesses from above LCRC as set by John A. Merdzinski in place of the 1" Iron over a 1" Iron over a Conc. Mon. he found. Said Irons & Conc. Mon. check with Kent Co. Wit. and LCRC #283

LCRC #2788		LCRC #5547	
Nail & KC tag 38" Pepperridge	N45°E 52.36'	Nail & KC tag 38" Pepperridge	
Nail & KC tag MBT Pole	N20°E 85.82'	N45°E 52.36'	
Nail & KC tag 14" Elm	N20°W 97.18'	Nail & KC tag Lt. Pole	S20°W 29.40'
Nail & KC tag MBT Pole	S20°W 29.57'	Nail & KC tag Tw. 10" Elm	S60°E 66.88'
Nail & KC tag MBT Pole	S75°E 111.34'	NE cor. metal bldg.	N40°W 74.15'
Nail & KC tag 10" Maple	N70°E 90.00'	On C/L Bit. Rd. E-W-N	

In C/L O'Brien St. & Collindale Ave.
The selected location is accepted by me and is generally accepted by professional surveyors as the best available evidence of the position of the original corner.

C. Description of monument for corner and accessories established to perpetuate locating the position of the corner:

F-11 Standard Kent County Monument			
New Nail & KC Remon. tag SE side 42" Pepperridge	N45°E	52.28'	
Nail & KC Remon. tag E. side Lt. Pole	S20°W	29.40'	
New Nail & KC Remon. tag N. side Tw. 12" Elm	S60°E	66.91'	
NE cor. metal bldg.-lift station	N40°W	74.30'	
On C/L Bit. Rd. E-W-N			

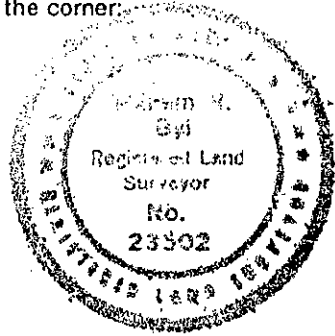

Signed by *W. R. Byl* Date 11-17-94
Surveyor's Michigan License No. 23502