

\$7.00 SEP 18 1995  
\$2.00 COMMISSION

KENT COUNTY REMONUMENTATION

STATE OF MICHIGAN  
COUNTY OF KENT  
RECEIVED FOR RECORD

LAND CORNER RECORDATION CERTIFICATE  
Filing Requirement of Act 74, Mich. P.A. 1970

95 MAY 12 AM 10:42

For corners in  
KENT COUNTY  
(County)

Located In: Corner Code #

- 1. Public Land Survey T 7N R 12W F-13
- 2. Property Controlling S \_\_\_\_\_ T \_\_\_\_\_ R \_\_\_\_\_
- in Section S \_\_\_\_\_ T \_\_\_\_\_ R \_\_\_\_\_
- 3. Miscellaneous S \_\_\_\_\_ T \_\_\_\_\_ R \_\_\_\_\_
- Property in Sec. S \_\_\_\_\_ T \_\_\_\_\_ R \_\_\_\_\_
- 4. Lot No. \_\_\_\_\_, Recorded Plat \_\_\_\_\_
- 5. Private Claims \_\_\_\_\_

*W. J. Bond*  
REG. OF DEEDS

8347A

Register of Deeds Stamp & File Number

A	B	C	D	E	F	G	H	I	J	K	L	M
2	6	5	4	3	2	1						
3												
4	7	8	9	10	11	12						
5												
6	13	17	16	15	14	13						
7												
8	19	20	21	22	23	24						
9												
10	30	29	28	27	26	25						
11												
12	31	32	33	34	35	36						
13												

I, Kirk Breitels, in a field survey on March 14, 1995, do hereby certify that under requirements of P.A. 74, Michigan P.A. of 1970, the corner points mentioned in lines 1 and 2 above were in conformance with regulations and rules therefore as required in the current manual of survey instructions of the United States Department of the Interior, Bureau of Land Management or by a decree of a Court of Law and/or that the corner points mentioned in lines 3, 4 and 5 above were in conformance with the rules of the Michigan Board of Land Surveyors or by a Decree of a Court of Law; established, re-established, monumented, re-monumented, recovered, found as expressed below:

NOTE: Not more than 4 corners, all in the same town and range, may be recorded on this certificate.

P.A. 345 1990 KENT COUNTY  
PEER APPROVED 3/30/95  
CHAIRMAN *Henry Huber*

A. Description of original monument and accessories and/or subsequent restoration:

F-13	1837	GLO	Brookfield	Set Post
	1939	Kent Co. Wit.		Iron, Stake & Stone
	1978	LCRC #1149	Bonnema	1/2" Iron
	1981	LCRC #1773	Merdzinski	Set Kent County Monument
	1990	LCRC #5548	Starr	Kent County Monument

The position of this corner was previously approved by the Kent County Remonumentation Peer Group, monumented by John A. Merdzinski on 2/2/81 and was recorded per LCRC 1773.

B. Description of corner evidence found and/or method applied in restoring or reestablishing corner:

F-13 DID NOT FIND standard Kent Co. Mon. - (POSITION NOW IN GRAVEL PIT LAKE) as set by John A. Merdzinski in place of the 1/2" Iron and possible remains of wood stake he found. Said Iron checks with Kent Co. Wit. and LCRC #1149.

<u>LCRC #1773</u>		<u>LCRC #5548</u>	
Nail & tag 16" Ash	N45°W 27.85'	KC Mon. - East	481.35'
Nail & tag 12" Ash	N85°W 20.02'	Nail & tag 12" Ash	N85°W 20.02'
Nail & tag 8" Ash	S45°W 50.34'	Nail & tag 8" Ash	S45°W 50.34'
Nail & tag 12" Ash	S10°W 55.67'	Nail & tag 12" Ash	S10°W 55.67'
Nail & tag 14" Poplar	S65°E 34.73'	Nail & tag 8" Ash	S55°E 2.19'
Nail & tag 6" Elm	N45°E 30.78'	Nail & tag 8" Poplar	N30°W 6.50'
Iron East	481.35'		

The selected location is accepted by me and is generally accepted by professional surveyors as the best available evidence of the position of the original corner.


C. Description of monument for corner and accessories established to perpetuate locating the position of the corner:

F-13 NO MONUMENT - CORNER IN GRAVEL PIT LAKE - SEE SKETCH REVERSE SIDE

USE F-1, T6N, R12W, WYOMING TWP. (LCRC #7436) AS A REFERENCE MONUMENT

Witnesses for F-1, T6N, R12W:

Nail & KC Remon. tag W. side 16" Willow	N10°E 6.14'
Nail & KC Remon. tag NW side 10" Ash	S40°W 4.17'
Nail & KC Remon. tag E. side Db1. 6" Silver Maple	N35°E 49.55'
Nail & KC Remon. tag N. side 15" Cottonwood	N35°W 107.82'
30' m/l West to edge of water	
Position of F-13 - West - 481.30'	

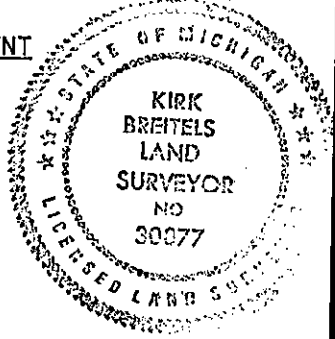

Signed by *Kirk Breitels*

Date 3/30/95

Surveyor's Michigan License No. 30077

SEP 18 1995

COMMISSION

