

SURVEY & REMONUMENTATION

KENT COUNTY REMONUMENTATION

APR 28 1995

LAND CORNER RECORDATION CERTIFICATE

Filing Requirement of Act 74, Mich. P.A. 1970

STATE OF MICHIGAN
COUNTY OF KENT
RECEIVED FOR RECORD

94 NOV 28 AM 11:47

Lucy J. J. J.
REG. OF DEEDS

For corners in
KENT COUNTY
(County)

COMMISSION

Located In:

Corner Code =#

1. Public Land Survey	T <u>7N</u> R <u>12W</u>	<u>G-7</u>
	T _____ R _____	_____
	T _____ R _____	_____
	T _____ R _____	_____
2. Property Controlling in Section	S _____ T _____ R _____	_____
	S _____ T _____ R _____	_____
3. Miscellaneous Property in Sec.	S _____ T _____ R _____	_____
	S _____ T _____ R _____	_____

7323

Register of Deeds Stamp & File Number

4. Lot No. _____, Recorded Plat _____
5. Private Claims _____

A	B	C	D	E	F	G	H	I	J	K	L	M
2	6	5	4	3	2	1						
3												
4	7	8	9	10	11	12						
5												
6	18	17	16	15	14	13						
7												
8	19	20	21	22	23	24						
9												
10	30	29	28	27	26	25						
11												
12	31	32	33	34	35	36						
13												

I, William R. Byl, in a field survey on July 19, 19 94, do hereby certify that under requirements of P.A. 74, Michigan P.A. of 1970, the corner points mentioned in lines 1 and 2 above were in conformance with regulations and rules therefore as required in the current manual of survey instructions of the United States Department of the Interior, Bureau of Land Management or by a decree of a Court of Law and/or that the corner points mentioned in lines 3, 4 and 5 above were in conformance with the rules of the Michigan Board of Land Surveyors or by a Decree of a Court of Law; established, re-established, monumented, re-monumented, recovered, found as expressed below:

NOTE: Not more than 4 corners, all in the same town and range, may be recorded on this certificate.

A. Description of original monument and accessories and/or subsequent restoration:

G-7	1837	GLO	Whitcomb	Set Post	P.A. 345 1990 KENT COUNTY
	1935	Kent Co. Wit.		Mon. Box	PEER APPROVED <u>11/17/94</u>
	1973	LCRC #448	VanKooten	Mon. Box	CHAIRMAN <i>Harry Huber</i>
	1982	LCRC #2792	Merdzinski	Set Kent County Monument	
	1988	LCRC #4898	Bueche	Reset Kent County Monument after const.	
	1990	LCRC #5554	Starr	Kent County Monument	

The position of this corner was previously approved by the Kent County Remonumentation Peer Group, monumented by John A. Merdzinski on 3/24/82 and was recorded per LCRC #2792

B. Description of corner evidence found and/or method applied in restoring or reestablishing corner:


G-7 Found standard Kent Co. Mon. (Harrison) per witnesses from above LCRC as set by John A. Merdzinski in place of the Rebar he found in a Mon. Box and later reset by John C. Bueche. Said Rebar in Mon. Box checks with Kent Co. Wit. and LCRC #448.

LCRC #2792	LCRC #5554
Nail & tag P. Pole N40°E 75.10'	Nail & tag Tri. 16" Maple N30°E 80.74'
Nail & tag P. & TV Pole N25°W 61.30'	Nail & tag 12" Pine N20°W 75.57'
Nail & tag 36" Maple S60°W 67.94'	Nail & tag 16" Tree S20°E 76.12'
Nail & tag 36" Maple S65°E 80.30'	Nail & tag 36" Maple S60°W 67.99'
Top centerline hydrant S20°W 80.33'	Nail & tag 36" Maple S65°E 80.39'
C/L E-W Rd. is N. 17'; On C/L N-S Rd.	Top C/L Hydrant S20°W 80.34'
	On C/L Oakleigh N-S; C/L Leonard 17' N.

The selected location is accepted by me and is generally accepted by professional surveyors as the best available evidence of the position of the original corner.

C. Description of monument for corner and accessories established to perpetuate locating the position of the corner:

G-7 Standard Kent County Monument	
New Nail & KC Remon. tag W. side Tri. 20" Maple	N30°E 80.74'
New Nail & KC Remon. tag W. side 18" Cedar	N20°W 75.57'
New Nail & KC Remon. tag E. side 24" Locust	S20°E 76.12'
New Nail & KC Remon. tag N. side 48" Maple	S60°W 68.00'
New Nail & KC Remon. tag S. side 48" Maple	S65°E 80.39'
Top C/L Hydrant	S20°W 80.22'
On C/L Oakleigh N-S; C/L Leonard 17' N.	

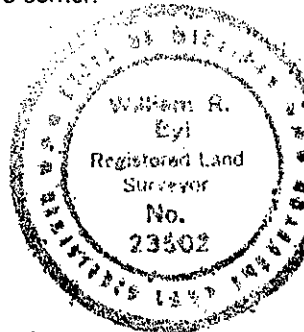

Signed by *William R. Byl* Date 11-17-94
Surveyor's Michigan License No. 23502