

SURVEY & REMONUMENTATION

KENT COUNTY REMONUMENTATION

LAND CORNER RECORDATION CERTIFICATE

Filing Requirement of Act 74, Mich. P.A. 1970

APR 28 1995

STATE OF MICHIGAN
COUNTY OF KENT
RECEIVED FOR RECORD
94 NOV 28 AM 11:48

For corners in

KENT COUNTY
(County)

COMMISSION Located In:

Corner Code #

- 1. Public Land Survey T 7N R 12W G-8
T _____ R _____
T _____ R _____
T _____ R _____
- 2. Property Controlling S _____ T _____ R _____
in Section S _____ T _____ R _____
- 3. Miscellaneous S _____ T _____ R _____
Property in Sec. S _____ T _____ R _____

7324

Register of Deeds Stamp & File Number

- 4. Lot No. _____, Recorded Plat _____
- 5. Private Claims _____

A	B	C	D	E	F	G	H	I	J	K	L	M
2	6	5	4	3	2	1						
3												
4	7	8	9	10	11	12						
5												
6	18	17	16	15	14	13						
7												
8	19	20	21	22	23	24						
9												
10	30	29	28	27	26	25						
11												
12	31	32	33	34	35	36						
13												

I, William R. Byl, in a field survey on June 30, 19 94, do hereby certify that under requirements of P.A. 74, Michigan P.A. of 1970, the corner points mentioned in lines 1 and 2 above were in conformance with regulations and rules therefore as required in the current manual of survey instructions of the United States Department of the Interior, Bureau of Land Management or by a decree of a Court of Law and/or that the corner points mentioned in lines 3, 4 and 5 above were in conformance with the rules of the Michigan Board of Land Surveyors or by a Decree of a Court of Law; established, re-established, monumented, re-monumented, recovered, found as expressed below:

NOTE: Not more than 4 corners, all in the same town and range, may be recorded on this certificate.

A. Description of original monument and accessories and/or subsequent restoration:

G-8	1837	GLO	Whitcomb	Set Post
	1940, 1956	Kent Co. Wit.		Mon. Box
	1973	LCRC #448	VanKooten	"T" Iron
	1982	LCRC #2793	Merdzinski	Set Kent County Monument
	1990	LCRC #5555	Starr	Kent County Monument

P.A. 345 1990 KENT COUNTY
PEER APPROVED 11/17/94
CHAIRMAN Hans Huber

The position of this corner was previously approved by the Kent County Remonumentation Peer Group, monumented by John A. Merdzinski on 3/23/82 and was recorded per LCRC #2793

B. Description of corner evidence found and/or method applied in restoring or reestablishing corner:


G-8 Found standard Kent Co. Mon. (Harrison) per witnesses from above LCRC as set by John A. Merdzinski in place of the "T" Iron he found. Said "T" Iron checks with Kent Co. Wit. & LCRC #448.

<u>LCRC #2793</u>		<u>LCRC #5555</u>	
Nail & tag P & T Pole	N50°W 37.30'	Nail & KC Remon. tag P & T Pole	N50°W 37.30'
Nail & tag Tele. Pole	S35°W 51.93'	Nail & KC Remon. tag Tele. Pole	S35°W 51.60'
Top centerline hydrant	S60°E 47.31'	Top centerline of hydrant	S60°E 47.31'
Top centerline hydrant	N50°E 37.93'	Top centerline of hydrant	N50°E 37.93'
Nail & tag 14" Hickory	N15°W 93.33'	West edge of manhole rim	East 3.64'
W. edge manhole rim	East 3.64'	On C/L Bit. Rd. N-S-E-W	

The selected location is accepted by me and is generally accepted by professional surveyors as the best available evidence of the position of the original corner.

C. Description of monument for corner and accessories established to perpetuate locating the position of the corner:

G-8 Standard Kent County Monument	
Nail & KC Remon. tag SE side P & T Pole	N50°W 37.32'
Nail & KC Remon. tag SE side Tele. Pole	S35°W 51.60'
Top centerline of hydrant	S60°E 47.40'
Top centerline of hydrant	N50°E 37.93'
W. edge manhole rim	N00°E 3.64'
On C/L Bit. Rd. N-S-E-W	

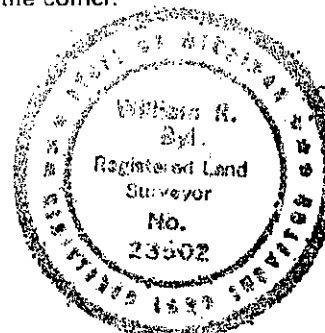

Signed by William R. Byl
Surveyor's Michigan License No. 23502

Date 11-17-94