

# SURVEY & REMONUMENTATION

KENT COUNTY REMONUMENTATION

APR 28 1995

**LAND CORNER RECORDATION CERTIFICATE**  
Filing Requirement of Act 74, Mich. P.A. 1970

STATE OF MICHIGAN  
COUNTY OF KENT  
RECEIVED FOR RECORD

94 DEC -5 AM 8:52

**COMMISSION**

For corners in  
**KENT COUNTY**

(County)

Located In:

Corner Code #

1. Public Land Survey	T <u>7N</u>	R <u>12W</u>	<u>G-13</u>
	T _____	R _____	_____
	T _____	R _____	_____
	T _____	R _____	_____
2. Property Controlling in Section	S _____	T _____	R _____
	S _____	T _____	R _____
3. Miscellaneous Property in Sec.	S _____	T _____	R _____
	S _____	T _____	R _____

*W. R. Byl*  
REG. OF DEEDS

**7593**

Register of Deeds Stamp & File Number

4. Lot No. \_\_\_\_\_, Recorded Plat \_\_\_\_\_  
5. Private Claims \_\_\_\_\_

	A	B	C	D	E	F	G	H	I	J	K	L	M
2	6	5	4	3	2	1							
3													
4	7	8	9	10	11	12							
5													
6	18	17	16	15	14	13							
7													
8	19	20	21	22	23	24							
9													
10	30	29	28	27	26	25							
11													
12	31	32	33	34	35	36							
13													

I, William R. Byl, in a field survey on Nov. 11, 19 94, do hereby certify that under requirements of P.A. 74, Michigan P.A. of 1970, the corner points mentioned in lines 1 and 2 above were in conformance with regulations and rules therefore as required in the current manual of survey instructions of the United States Department of the Interior, Bureau of Land Management or by a decree of a Court of Law and/or that the corner points mentioned in lines 3, 4 and 5 above were in conformance with the rules of the Michigan Board of Land Surveyors or by a Decree of a Court of Law; established, re-established, monumented, re-monumented, recovered, found as expressed below:

**NOTE: Not more than 4 corners, all in the same town and range, may be recorded on this certificate.**

A. Description of original monument and accessories and/or subsequent restoration:

G-13	1837	GLO	Brookfield	Set Post
	1879-1939	Williams & Works		Replaced "old gov't. post"
				with large stone with copper plug
		Kent Co. Wit.		Copper Pointed Stone
	1985	LCRC #4132	Byl	Set Kent County Monument
	1990	LCRC #5560	Starr	Kent County Monument

The position of this corner was previously approved by the Kent County Remonumentation Peer Group, monumented by William R. Byl on 1/3/85 and was recorded per LCRC #4132

B. Description of corner evidence found and/or method applied in restoring or reestablishing corner:


G-13 Found standard Kent Co. Mon. (Harrison) per witnesses from above LCRC as set by William R. Byl over the top of a copper plug in a stone that he found. Said Stone checks with Williams & Works and Kent Co. Wit.

<u>LCRC #4132</u>	<u>LCRC #5560</u>
Nail & tag 30" Maple N10°W 11.33'	Nail & KC tag W. side 10" Ash S20°E 24.75'
Nail & tag 10" Maple N50°E 9.95'	Nail & KC tag E. side 30" dead Maple N10°W 11.33'
Nail & tag 12" Ash S05°E 32.20'	Nail & KC tag N. side 10" dead Maple N50°E 9.95'
Nail & tag 30" Oak N00°E 29.70'	Nail & KC tag W. side 12" Ash stump S05°E 32.20'
Nail & tag P. Pole N85°E 23.65'	Nail & KC tag W. side 30" Oak N00°E 29.70'
	Nail & KC tag S. side P. Pole N85°E 23.65'
	KC Mon. East 348.48'

The selected location is accepted by me and is generally accepted by professional surveyors as the best available evidence of the position of the original corner.

C. Description of monument for corner and accessories established to perpetuate locating the position of the corner:

G-13 Standard Kent County Monument		
Nail & KC Remon. tag W. side 10" Ash	S20°E	24.75'
Nail & KC Remon. tag W. side 12" Ash stump	S05°E	32.20'
New Nail & KC Remon. tag W. side 30" Oak	N00°E	29.70'
Nail & KC Remon. tag S. side P. Pole	N85°E	23.65'
Set Nail & KC Remon. tag NE side 6" Ash	S45°E	14.75'
KC Mon. (G-1, T6N, R12W)	S90°E	348.48'

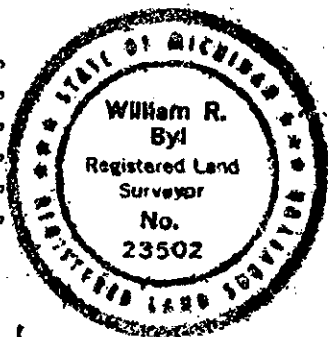

Signed by W. R. Byl Date 11/27/94  
 Surveyor's Michigan License No. 23502  
 P.A. 345 1990 KENT COUNTY  
 PEER APPROVED 12/11/94  
 CHAIRMAN Harry Huber