

SURVEY & REMONUMENTATION

APR 28 1995

KENT COUNTY REMONUMENTATION

LAND CORNER RECORDATION CERTIFICATE

Filing Requirement of Act 74, Mich. P.A. 1970

STATE OF MICHIGAN
COUNTY OF KENT
RECEIVED FOR RECORD

94 NOV 28 AM 11:48

COMMISSION

For corners in
KENT COUNTY

(County)	Located In:	Corner Code =#
1. Public Land Survey	T <u>7N</u> R <u>12W</u>	<u>H-1</u>
	T _____ R _____	_____
	T _____ R _____	_____
	T _____ R _____	_____
2. Property Controlling in Section	S _____ T _____ R _____	_____
	S _____ T _____ R _____	_____
3. Miscellaneous Property in Sec.	S _____ T _____ R _____	_____
	S _____ T _____ R _____	_____

Lucy Bond
REG. OF DEEDS

7328

Register of Deeds Stamp & File Number

4. Lot No. _____, Recorded Plat _____
5. Private Claims _____

	A	B	C	D	E	F	G	H	I	J	K	L	M
2	6		5		4		3		2		1		
3													
4	7		8		9		10		11		12		
5													
6	18		17		16		15		14		13		
7													
8	19		20		21		22		23		24		
9													
10	30		29		28		27		26		25		
11													
12	31		32		33		34		35		36		
13													

I, William R. Byl, in a field survey on July 27, 19 94, do hereby certify that under requirements of P.A. 74, Michigan P.A. of 1970, the corner points mentioned in lines 1 and 2 above were in conformance with regulations and rules therefore as required in the current manual of survey instructions of the United States Department of the Interior, Bureau of Land Management or by a decree of a Court of Law and/or that the corner points mentioned in lines 3, 4 and 5 above were in conformance with the rules of the Michigan Board of Land Surveyors or by a Decree of a Court of Law; established, re-established, monumented, re-monumented, recovered, found as expressed below:

NOTE: Not more than 4 corners, all in the same town and range, may be recorded on this certificate.

A. Description of original monument and accessories and/or subsequent restoration:

H-1	1837	GLO		Not Set
		Kent Co. Wit.		Stone & Iron
	1971	LCRC #67	Spicer	"T" Iron
	1981	LCRC #1840	Hackbardt	Set Kent County Monument

The position of this corner was previously approved by the Kent County Remonumentation Peer Group, monumented by Glen S. Hackbardt on 3/31/81 and was recorded per LCRC #1840

B. Description of corner evidence found and/or method applied in restoring or reestablishing corner:

H-1 Found standard Kent Co. Mon. (Harrison) per witnesses from above LCRC as set by Glen S. Hackbardt in place of the "T" Iron he found. Said "T" Iron checks with Kent Co. Wit. and LCRC #67.

LCRC #1840

SE corner Blk. Bldg.	N50°W	133.55'
KC Nail & tag 18" Walnut	N70°W	133.51'
KC Nail & tag 30" Maple	S80°W	113.95'
KC Nail & tag CP	S50°W	91.68'
Harrison Mon.	West	30.62'

P.A. 345 1990 KENT COUNTY

PEER APPROVED 11/17/94


CHAIRMAN *[Signature]*

The selected location is accepted by me and is generally accepted by professional surveyors as the best available evidence of the position of the corner.

C. Description of monument for corner and accessories established to perpetuate locating the position of the corner:

H-1 Standard Kent County Monument

SE corner Blk. Bldg.	N50°W	133.48'
New Nail & KC Remon. tag S. side 24" Walnut	N70°W	133.53'
New Nail & KC Remon. tag SE side P. Pole	S50°W	91.63'
Set Nail & KC Remon. tag S. side P. Pole	S60°W	38.16'
Kent Co. Mon. (H-13 T8N, R12W)	S90°W	30.62'

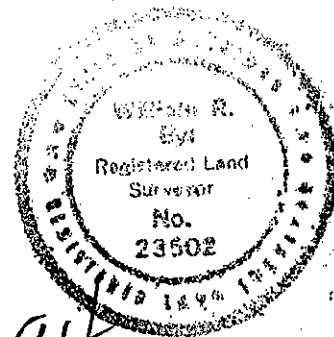

Signed by *[Signature]* Date 11-17-94
Surveyor's Michigan License No. 23502