

SURVEY & REMONUMENTATION

KENT COUNTY REMONUMENTATION

APR 28 1995

LAND CORNER RECORDATION CERTIFICATE COMMISSION

Filing Requirement of Act 74, Mich. P.A. 1970

STATE OF MICHIGAN
COUNTY OF KENT
RECEIVED FOR RECORD

94 NOV 28 AM 11:48

For corners in
KENT COUNTY
(County)

Located In: Corner Code #


- | | | |
|---------------------------------------|--------------------------|-------|
| 1. Public Land Survey | T <u>7N</u> R <u>12W</u> | H-7 |
| | T _____ R _____ | _____ |
| | T _____ R _____ | _____ |
| | T _____ R _____ | _____ |
| 2. Property Controlling in Section | S _____ T _____ R _____ | _____ |
| | S _____ T _____ R _____ | _____ |
| 3. Miscellaneous Property in Sec. | S _____ T _____ R _____ | _____ |
| | S _____ T _____ R _____ | _____ |
| 4. Lot No. _____, Recorded Plat _____ | | |
| 5. Private Claims _____ | | |

Lucy Bond
REG. OF DEEDS

7331

Register of Deeds Stamp & File Number

I, William R. Byl, in a field survey on March 3, 1994, do hereby certify that under requirements of P.A. 74, Michigan P.A. of 1970, the corner points mentioned in lines 1 and 2 above were in conformance with regulations and rules therefore as required in the current manual of survey instructions of the United States Department of the Interior, Bureau of Land Management or by a decree of a Court of Law and/or that the corner points mentioned in lines 3, 4 and 5 above were in conformance with the rules of the Michigan Board of Land Surveyors or by a Decree of a Court of Law; established, re-established, monumented, re-monumented, recovered, found as expressed below:

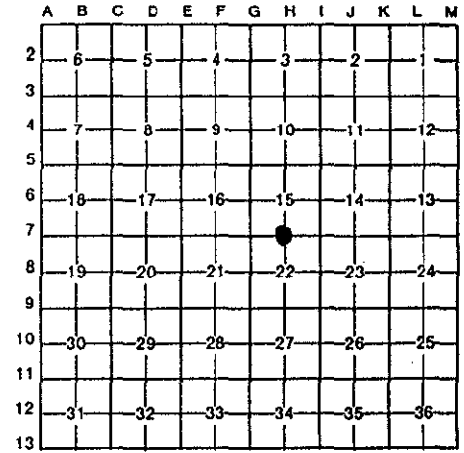

NOTE: Not more than 4 corners, all in the same town and range, may be recorded on this certificate.

A. Description of original monument and accessories and/or subsequent restoration:

H-7	1837	GLO	Whitcomb	Set Post
	1935	Kent Co. Wit.		Mon. Box
	1966	Williams & Works		Mon. Box
	1983	LCRC #3509	Byl	Set Kent County Monument

The position of this corner was previously approved by the Kent County Remonumentation Peer Group, monumented by William R. Byl on 7/27/83 and was recorded per LCRC #3509

B. Description of corner evidence found and/or method applied in restoring or reestablishing corner:

H-7 Found standard Kent Co. Mon. (Harrison) per witnesses from above LCRC as set by William R. Byl on top of a Iron he found in a Mon. Box. Said Iron in Mon. Box checks with Kent Co. Wit. and Williams & Works information.

LCRC #3509

C/L to of Hydrant	S30°W	44.95'
NW cor. brick fire station	S25°E	95.72'
NE cor. brick veneer of store	S70°E	116.9'
Nail & tag N. side MBT pole	S75°W	73.55'

P.A. 345 1990 KENT COUNTY


PEER APPROVED 11/17/94

CHAIRMAN *Harry Fisher*

The selected location is accepted by me and is generally accepted by professional surveyors as the best available evidence of the position of the original corner.

C. Description of monument for corner and accessories established to perpetuate locating the position of the corner:

H-7 Standard Kent County Monument		
NE cor. brick veneer of store	S70°W	116.92'
NW cor. brick fire station (new)	S30°E	108.01'
C/L top of hydrant (new)	S15°W	57.11'
Set Nail & KC Remon. tag SW side Power Pole	N25°W	63.83'
Set Nail & KC Remon. tag SE side Power Pole	N25°E	56.13'

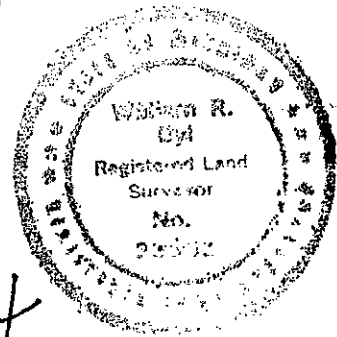

Signed by *W. R. Byl* Date 11-17-94
Surveyor's Michigan License No. 23502