

SURVEY & REMONUMENTATION

APR 28 1995

KENT COUNTY REMONUMENTATION

STATE OF MICHIGAN
COUNTY OF KENT
RECEIVED FOR RECORD

COMMISSION

LAND CORNER RECORDATION CERTIFICATE

Filing Requirement of Act 74, Mich. P.A. 1970

94 NOV 28 AM 11:48

For corners in
KENT COUNTY
(County)

Located In: Corner Code=#

| | | |
|------------------------------------|--------------------------|-------------|
| 1. Public Land Survey | T <u>7N</u> R <u>12W</u> | <u>H-11</u> |
| | T _____ R _____ | _____ |
| | T _____ R _____ | _____ |
| | T _____ R _____ | _____ |
| 2. Property Controlling in Section | S _____ T _____ R _____ | _____ |
| | S _____ T _____ R _____ | _____ |
| 3. Miscellaneous Property in Sec. | S _____ T _____ R _____ | _____ |
| | S _____ T _____ R _____ | _____ |

Lucy Bond
REG. OF DEEDS

7333

Register of Deeds Stamp & File Number

4. Lot No. _____, Recorded Plat _____
5. Private Claims _____

| | A | B | C | D | E | F | G | H | I | J | K | L | M |
|----|----|----|----|----|----|----|---|---|---|---|---|---|---|
| 2 | 6 | 5 | 4 | 3 | 2 | 1 | | | | | | | |
| 3 | | | | | | | | | | | | | |
| 4 | 7 | 8 | 9 | 10 | 11 | 12 | | | | | | | |
| 5 | | | | | | | | | | | | | |
| 6 | 18 | 17 | 16 | 15 | 14 | 13 | | | | | | | |
| 7 | | | | | | | | | | | | | |
| 8 | 19 | 20 | 21 | 22 | 23 | 24 | | | | | | | |
| 9 | | | | | | | | | | | | | |
| 10 | 30 | 29 | 28 | 27 | 26 | 25 | | | | | | | |
| 11 | | | | | | | | | | | | | |
| 12 | 31 | 32 | 33 | 34 | 35 | 36 | | | | | | | |
| 13 | | | | | | | | | | | | | |

I, William R. Byl, in a field survey on May 27, 1993, do hereby certify that under requirements of P.A. 74, Michigan P.A. of 1970, the corner points mentioned in lines 1 and 2 above were in conformance with regulations and rules therefore as required in the current manual of survey instructions of the United States Department of the Interior, Bureau of Land Management or by a decree of a Court of Law and/or that the corner points mentioned in lines 3, 4 and 5 above were in conformance with the rules of the Michigan Board of Land Surveyors or by a Decree of a Court of Law; established, re-established, monumented, re-monumented, recovered, found as expressed below:

NOTE: Not more than 4 corners, all in the same town and range, may be recorded on this certificate.

A. Description of original monument and accessories and/or subsequent restoration:

| | | | | |
|------|------|---------------|----------|---|
| H-11 | 1837 | GLO | Whitcomb | Set Post |
| | | Kent Co. Wit. | | Conc. Monument |
| | 1975 | LCRC #841 | Chambers | 3/4" Iron |
| | 1983 | LCRC #3316 | Tobin | Set Kent County Monument |
| | 1984 | LCRC #3848 | Meyer | Reset Kent County Monument after const. |

P.A. 345 1990 KENT COUNTY
PEER APPROVED 11/17/94
CHAIRMAN *Harry Huber*

The position of this corner was previously approved by the Kent County Remonumentation Peer Group, monumented by Douglas J. Tobin on 5/18/82 and was recorded per LCRC #3316

B. Description of corner evidence found and/or method applied in restoring or reestablishing corner:


H-11 Found standard Kent Co. Mon. (Harrison) per witnesses from above LCRC as set by Douglas J. Tobin (and reset by Allan L. Meyer) in place of the 3/4" x 6" Iron he found over a concrete monument 8" below ground. Said Iron and conc. mon. checks with Kent Co. Wit. and LCRC #841.

| LCRC #3316 | | North | 5.30' | LCRC #3848 | same witnesses as LCRC #3316 |
|----------------------------------|-------|-------|--------|------------|------------------------------|
| C/L "X" of manhole cover | | | | | |
| KC tag & nail in W. side 12" Oak | S15°W | | 57.90' | | |
| KC tag & nail in E. side 15" Oak | S55°E | | 52.80' | | NOTE: witness bearings for |
| KC tag & nail in E. side 13" Oak | S15°E | | 71.05' | | last 3 witnesses on LCRC |
| KC tag & nail in NE side 13" Oak | S35°E | | 58.35' | | #3316 are incorrect. |

The selected location is accepted by me and is generally accepted by professional surveyors as the best available evidence of the position of the original corner.

C. Description of monument for corner and accessories established to perpetuate locating the position of the corner:

| | | | | |
|--------------------------------------|-------|--------|--|--|
| H-11 Standard Kent County Monument | | | | |
| C/L "X" of manhole cover | N00°E | 5.17' | | |
| New KC tag & nail in W. side 15" Oak | S15°W | 57.84' | | |
| New KC tag & nail in E. side 18" Oak | S15°E | 52.75' | | |
| New KC tag & nail in E. side 15" Oak | S35°E | 71.02' | | |
| New KC tag & nail in NE side 15" Oak | S55°E | 58.35' | | |
| Set KC tag & nail in NW side P. Pole | N40°E | 87.53' | | |
| Set KC tag & nail in S. side 48" Oak | N70°W | 91.10' | | |

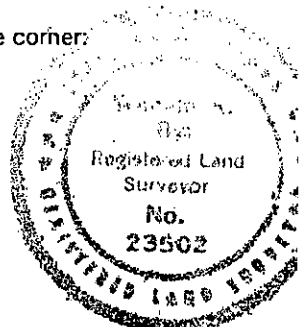

Signed by *W. R. Byl*
Surveyor's Michigan License No. 23502

Date 11-17-94