

JAN 24 1996

KENT COUNTY REMONUMENTATION

COMMISSION

LAND CORNER RECORDATION CERTIFICATE

Filing Requirement of Act 74, Mich. P.A. 1970

For corners in KENT COUNTY (County)

Located In:

Corner Code #

- 1. Public Land Survey T 7N R 12W H-12
2. Property Controlling in Section S T R
3. Miscellaneous Property in Section S T R

- 4. Lot No. Recorded Plat
5. Private Claims

STATE OF MICHIGAN COUNTY OF KENT RECEIVED FOR RECORD 95 DEC 26 PM 12:43 REG. OF DEEDS

8867

Register of Deeds Stamp & File Number

I, Kirk Breitels, in a field survey on April 21, 1995

do hereby certify that under requirements of P.A. 74, Michigan P.A. of 1970, the corner points mentioned in lines 1 and 2 above were in conformance with regulations and rules therefore as required in the current manual of survey instructions of the United States Department of the Interior, Bureau of Land Management or by a decree of a Court of Law and/or that the corner points mentioned in lines 3, 4 and 5 above were in conformance with the rules of the Michigan Board of Professional Surveyors or by a Decree of a Court of Law; established, re-established, monumented, re-monumented, recovered, found as expressed below:

NOTE: Not more than 4 corners, all in the same town and range, may be recorded on this certificate.

Grid table with columns A-M and rows 1-13. Cell H-12 is circled.

A. Description of original monument and accessories and/or subsequent restoration:

H-12 1837 GLO Not Set
1903-64 Williams & Works 2" Gas Pipe
Kent Co. Wit. City Iron
1984 Williams & Works Set Iron per 1959 witnesses
1994 Nederveid & Assoc. Survey - computed "X" 1/4 lines

B. Description of corner evidence found and/or method applied in restoring or reestablishing corner:


H-12 Found bent "T" Iron in undisturbed area (approx. 10 years) of city fill area. Fits Williams & Works 1/4 line measurements to East and North from 1959 survey by 00°02' more or less and by 1' more or less. Also fits nearest property iron found (879' ENE) from 1959 survey by 0.20' and 00°00'40". Also used by Exxel Eng. recently - agree with measurement to West 1/4 corner. "T" Iron is 16.2' N. and 4.8' W. from true intersection of 1/4 lines.

The "T" Iron is accepted by me and is generally accepted by professional surveyors as the best available evidence of the position of the corner.

P.A. 345 1990 KENT COUNTY PEER APPROVED 4/27/95 CHAIRMAN Harrison

C. Description of monument for corner and accessories established to perpetuate locating the position of the corner:

H-12 Set standard Kent County Monument (Harrison) in place of bent "T" iron. Set Nail & KC Remon. tag E. side 6" Poplar N35°W 97.88' Set Nail & KC Remon. tag N. side 15" Poplar S60°W 115.98' Set Nail & KC Remon. tag E. side 15" Tw. Poplar S10°E 123.56' Set Nail & KC Remon. tag E. side 14" Poplar S30°E 197.33' Set Nail & KC Remon. tag NE side 9" Poplar S55°E 195.02' Bottom of slope - East 340'+ Bottom of slope - North 300'+

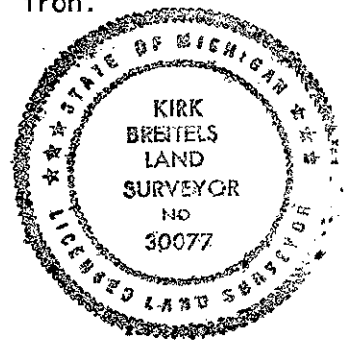

Signed by Kirk Breitels

Date 12/14/95

Surveyor's Michigan License No. 30077