

SURVEY & REMONUMENTATION

KENT COUNTY REMONUMENTATION

APR 28 1995

LAND CORNER RECORDATION CERTIFICATE
Filing Requirement of Act 74, Mich. P.A. 1970

STATE OF MICHIGAN
COUNTY OF KENT
RECEIVED FOR RECORD

94 NOV 28 AM 11:48

COMMISSION

For corners in
KENT COUNTY

Located In:

Corner Code =#

1. Public Land Survey T 7N R 12W I-2
2. Property Controlling in Section S _____ T _____ R _____
3. Miscellaneous Property in Sec. S _____ T _____ R _____
4. Lot No. _____, Recorded Plat _____
5. Private Claims _____

Wendell Bond
REG. OF DEEDS

7336

Register of Deeds Stamp & File Number

	A	B	C	D	E	F	G	H	I	J	K	L	M
2	6		5		4		3		2		1		
3													
4	7		8		9		10		11		12		
5													
6	18		17		16		15		14		13		
7													
8	19		20		21		22		23		24		
9													
10	30		29		28		27		26		25		
11													
12	31		32		33		34		35		36		
13													

I, William R. Byl, in a field survey on May 27, 1993, do hereby certify that under requirements of P.A. 74, Michigan P.A. of 1970, the corner points mentioned in lines 1 and 2 above were in conformance with regulations and rules therefore as required in the current manual of survey instructions of the United States Department of the Interior, Bureau of Land Management or by a decree of a Court of Law and/or that the corner points mentioned in lines 3, 4 and 5 above were in conformance with the rules of the Michigan Board of Land Surveyors or by a Decree of a Court of Law; established, re-established, monumented, re-monumented, recovered, found as expressed below:

NOTE: Not more than 4 corners, all in the same town and range, may be recorded on this certificate.

A. Description of original monument and accessories and/or subsequent restoration:

I-2	1837	GLO	Whitcomb	Set Post
	1960	Kent Co. Wit.	MDSH	RR Spike
	1974	LCRC #753	Spicer	RR Spike
	1981	LCRC #1839	Hackbardt	Set Kent County Monument

The position of this corner was previously approved by the Kent County Remonumentation Peer Group, monumented by Glen S. Hackbardt on 3/31/81 and was recorded per LCRC #1839

B. Description of corner evidence found and/or method applied in restoring or reestablishing corner:

I-2 Found standard Kent Co. Mon. (Harrison) per witnesses from above LCRC as set by Glen S. Hackbardt in place of the RR Spike he found over a 1" Iron 2' below surface. Both RR Spike & 1" Iron check with Kent Co. Wit. & LCRC #753

LCRC #1839

SW cor. conc. hdwl.	N25°W	80.20'
KC Nail & tag in 36" Maple	N40°E	63.52'
KC Nail & tag in 20" Oak	S50°E	60.30'
KC Nail & tag in C.P. Pole	N80°W	64.00'


P.A. 345 1990 KENT COUNTY
PEER APPROVED 11/17/94
CHAIRMAN *Henry Huber*

The selected location is accepted by me and is generally accepted by professional surveyors as the best available evidence of the position of the original corner.

C. Description of monument for corner and accessories established to perpetuate locating the position of the corner:

I-2 Standard Kent County Monument

SW cor. conc. hdwl.	N25°W	80.30'
New Nail & KC Remon. tag NW side 40" Maple	N40°E	63.30'
New Nail & KC Remon. tag SW side 24" Oak	S50°E	60.15'
Nail & KC Remon. tag N. side C.P. Pole	N80°W	64.00'
Set Nail & KC Remon. tag S. side 18" Poplar	S75°E	40.51'

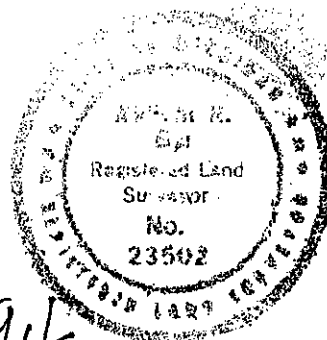

Signed by *W. R. Byl*
Surveyor's Michigan License No. 23502

Date 11-17-94