

SURVEY & REMONUMENTATION

KENT COUNTY REMONUMENTATION

STATE OF MICHIGAN
COUNTY OF KENT
RECEIVED FOR RECORD

APR 28 1995

LAND CORNER RECORDATION CERTIFICATE
Filing Requirement of Act 74, Mich. P.A. 1970

NOV 28 AM 11:48

For corners in **COMMISSION**
KENT COUNTY

(County)	Located In:	Corner Code #
1. Public Land Survey	T <u>7N</u> R <u>12W</u>	<u>I-3</u>
	T _____ R _____	_____
	T _____ R _____	_____
	T _____ R _____	_____
2. Property Controlling in Section	S _____ T _____ R _____	_____
	S _____ T _____ R _____	_____
3. Miscellaneous Property in Sec.	S _____ T _____ R _____	_____
	S _____ T _____ R _____	_____
4. Lot No. _____, Recorded Plat _____		
5. Private Claims _____		

David Bond
REG. OF DEEDS

7337

Register of Deeds Stamp & File Number

A	B	C	D	E	F	G	H	I	J	K	L	M
2	6	5	4	3	2	1						
3												
4	7	8	9	10	11	12						
5												
6	18	17	16	15	14	13						
7												
8	19	20	21	22	23	24						
9												
10	30	29	28	27	26	25						
11												
12	31	32	33	34	35	36						
13												

I, William R. Byl, in a field survey on May 28, 19 93, do hereby certify that under requirements of P.A. 74, Michigan P.A. of 1970, the corner points mentioned in lines 1 and 2 above were in conformance with regulations and rules therefore as required in the current manual of survey instructions of the United States Department of the Interior, Bureau of Land Management or by a decree of a Court of Law and/or that the corner points mentioned in lines 3, 4 and 5 above were in conformance with the rules of the Michigan Board of Land Surveyors or by a Decree of a Court of Law; established, re-established, monumented, re-monumented, recovered, found as expressed below:

NOTE: Not more than 4 corners, all in the same town and range, may be recorded on this certificate.

A. Description of original monument and accessories and/or subsequent restoration:

I-3	1837	GLO	Whitcomb	Set Post
	1960	Kent Co. Wit.	MDSH	1 1/4" Iron
	1974	LCRC #753	Spicer	1 1/4" Iron in mon. box
	1981	LCRC #1854	Tobin	Set Kent County Monument
	1991	LCRC #6187	McCloskey	Kent County Monument

P.A. 345 1990 KENT COUNTY

PEER APPROVED 11/17/94
CHAIRMAN *David Huber*

The position of this corner was previously approved by the Kent County Remonumentation Peer Group, monumented by Douglas J. Tobin on 4/20/81 and was recorded per LCRC #1854

B. Description of corner evidence found and/or method applied in restoring or reestablishing corner:


I-3 Found standard Kent Co. Mon. (Harrison) per witnesses from above LCRC as set by Douglas J. Tobin in place of the 1 1/4" Iron he found in a mon. box. Said 1 1/4" Iron in mon. box checks with Kent Co. Wit. & LCRC #753.

<u>LCRC #1854</u>	<u>LCRC #6187</u>
Top C/L hydr.	N45°W 54.62' Nail & tag P. Pole S60°W 81.05'
Nail & tag 26" Chestnut	N35°E 59.64' Nail & tag 26" Chestnut N35°E 59.64'
Nail & tag P. Pole	S60°W 85.40' Top center hydrant N45°W 54.62'
Face of N. gas vent	S35°E 60.15' Nail & tag P. Pole N20°W 91.07'
	Nail & tag P. Pole S45°W 65.25'

The selected location is accepted by me and is generally accepted by professional surveyors as the best available evidence of the position of the original corner.

C. Description of monument for corner and accessories established to perpetuate locating the position of the corner:

I-3 Standard Kent County Monument	
Nail & KC Remon. tag SE side P. Pole	S60°W 81.05'
New Nail & KC Remon. tag SE side 30" Chestnut	N35°E 59.64'
Top Center Hydrant	N45°W 54.62'
Nail & MDSH tag E. side P. Pole	N20°W 91.07'
Nail & KC Remon. tag SW side P. Pole	S45°E 65.25'
C/L 3 Mile Rd. (blktp) is South 12' m/1	

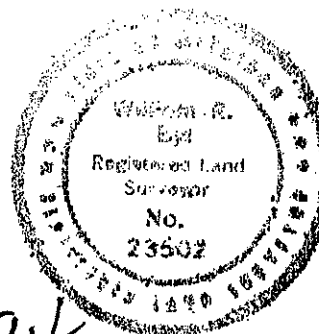

Signed by *W. R. Byl*
Surveyor's Michigan License No. 23502

Date 11-17-94