

SURVEY & REMONUMENTATION

KENT COUNTY REMONUMENTATION

STATE OF MICHIGAN
COUNTY OF KENT
RECEIVED FOR RECORD

APR 28 1995

LAND CORNER RECORDATION CERTIFICATE
Filing Requirement of Act 74, Mich. P.A. 1970

94 NOV 28 AM 11:48

For corners in **COMMISSION**
KENT COUNTY

W. R. Byl
REG. OF DEEDS

(County)	Located In:	Corner Code #
1. Public Land Survey	T <u>7N</u> R <u>12W</u>	<u>I-4</u>
	T _____ R _____	_____
	T _____ R _____	_____
	T _____ R _____	_____
2. Property Controlling in Section	S _____ T _____ R _____	_____
	S _____ T _____ R _____	_____
3. Miscellaneous Property in Sec.	S _____ T _____ R _____	_____
	S _____ T _____ R _____	_____
4. Lot No. _____, Recorded Plat _____		
5. Private Claims _____		

7338
Register of Deeds Stamp & File Number

I, William R. Byl, in a field survey on June 6, 19 94, do hereby certify that under requirements of P.A. 74, Michigan P.A. of 1970, the corner points mentioned in lines 1 and 2 above were in conformance with regulations and rules therefore as required in the current manual of survey instructions of the United States Department of the Interior, Bureau of Land Management or by a decree of a Court of Law and/or that the corner points mentioned in lines 3, 4 and 5 above were in conformance with the rules of the Michigan Board of Land Surveyors or by a Decree of a Court of Law; established, re-established, monumented, re-monumented, recovered, found as expressed below:

	A	B	C	D	E	F	G	H	I	J	K	L	M
2	6	5	4	3	2	1							
3													
4	7	8	9	10	11	12							
5													
6	13	17	16	15	14	13							
7													
8	19	20	21	22	23	24							
9													
10	30	29	28	27	26	25							
11													
12	31	32	33	34	35	36							
13													

NOTE: Not more than 4 corners, all in the same town and range, may be recorded on this certificate.

A. Description of original monument and accessories and/or subsequent restoration:

I-4	1837	GLO	Whitcomb	Set Post
	1946	Kent Co. Wit.		Mon. Box
	1971	LCRC #64	Chambers	Iron in Mon. Box
	1981	LCRC #1845	Shangraw	Set Kent County Monument

P.A. 345 1990 KENT COUNTY

PEER APPROVED 11/17/94
CHAIRMAN *Harry Shubert*

The position of this corner was previously approved by the Kent County Remonumentation Peer Group, monumented by Carl F. Shangraw on 5/21/81 and was recorded per LCRC #1845.

B. Description of corner evidence found and/or method applied in restoring or reestablishing corner:

I-4 Found standard Kent Co. Mon. (Harrison) per witnesses from above LCRC as set by Carl F. Shangraw in place of a 1 1/2" Iron in Mon. Box and a 1" Iron 20" below grade that he found. Both Irons check with Kent Co. Wit and LCRC #64.


LCRC #1845

KC Nail & tag S. side P & T Pole	N90°E	32.90'
KC Nail & tag SE side Tw. 12" Black Oak	N45°E	54.95'
KC Nail & tag in P. Pole	N74°W	67.19'
KC Nail & tag in P. Pole	S75°W	82.03'

The selected location is accepted by me and is generally accepted by professional surveyors as the best available evidence of the position of the original corner.

C. Description of monument for corner and accessories established to perpetuate locating the position of the corner:

I-4 Standard Kent County Monument		
KC Nail & tag S. side P & T Pole	N90°E	32.86'
New KC Nail & tag SE side Tw. 16" Black Oak	N45°E	54.87'
KC Nail & tag in P. Pole	N74°W	67.04'
KC Nail & tag in P. Pole	S75°W	81.96'

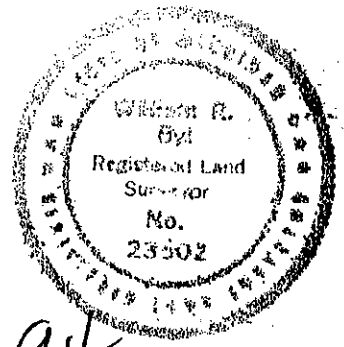

Signed by *W. R. Byl* Date 11-17-94
Surveyor's Michigan License No. 23502