

SURVEY & REMONUMENTATION

KENT COUNTY REMONUMENTATION

APR 28 1995

COMMISSION

LAND CORNER RECORDATION CERTIFICATE
Filing Requirement of Act 74, Mich. P.A. 1970

STATE OF MICHIGAN
COUNTY OF KENT
RECEIVED FOR RECORD

94 NOV 28 AM 11:49

For corners in
KENT COUNTY
(County)

Located In: Corner Code ##

- | | | | | | |
|------------------------------------|---|-----------|---|------------|-----|
| 1. Public Land Survey | T | <u>7N</u> | R | <u>12W</u> | I-8 |
| | T | | R | | |
| | T | | R | | |
| | T | | R | | |
| 2. Property Controlling in Section | S | | T | R | |
| | S | | T | R | |
| 3. Miscellaneous Property in Sec. | S | | T | R | |
| | S | | T | R | |

W. R. Dyl
REG. OF DEEDS

7342

Register of Deeds Stamp & File Number

4. Lot No. _____, Recorded Plat _____
5. Private Claims _____

I, William R. Bvl, in a field survey on April 22, 19 93, do hereby certify that under requirements of P.A. 74, Michigan P.A. of 1970, the corner points mentioned in lines 1 and 2 above were in conformance with regulations and rules therefore as required in the current manual of survey instructions of the United States Department of the Interior, Bureau of Land Management or by a decree of a Court of Law and/or that the corner points mentioned in lines 3, 4 and 5 above were in conformance with the rules of the Michigan Board of Land Surveyors or by a Decree of a Court of Law; established, re-established, monumented, re-monumented, recovered, found as expressed below:

NOTE: Not more than 4 corners, all in the same town and range, may be recorded on this certificate.

A. Description of original monument and accessories and/or subsequent restoration:

I-8	1837	GLO	Whitcomb	Set Post
		Kent Co. Wit.		Cut on manhole rim
	1973	LCRC #499	Spicer	1" cut s on manhole rim
	1982	LCRC #2799	Merdzinski	Cross-cut on manhole cover at intersection of cuts on rim

P.A. 345 1990 KENT COUNTY

PEER APPROVED 11/17/94
CHAIRMAN *[Signature]*

The position of this corner was previously approved by the Kent County Remonumentation Peer Group, monumented (Cross-cut on manhole, no Kent Co. Mon. set) by John A. Merdzinski on 3/19/82 and recorded per LCRC #2799

B. Description of corner evidence found and/or method applied in restoring or reestablishing corner:

I-8 Found cut marks on manhole rim and intersected at a point. Said point fits witnesses per above LCRC as used by John A. Merdzinski. Said point on manhole cover checks with Kent Co. Wit. and LCRC #499.


LCRC #2799

NE corner house foundation	S50°W	69.00'
NW corner brick house	S40°E	89.85'
SW corner brick house	N55°E	76.05'
C/L hydrant	N25°W	48.05'
C/L manhole cover is 0.25' South of corner		
Manhole at C/L "X" of Bristol & 7th St.		

The selected location is accepted by me and is generally accepted by professional surveyors as the best available evidence of the position of the original corner.

C. Description of monument for corner and accessories established to perpetuate locating the position of the corner:

I-8 Unmarked point on manhole cover at intersection of cut marks on rim.		
NE corner house foundation	S50°W	69.00'
NW corner brick house	S40°E	89.85'
SW corner brick house	N55°E	76.10'
C/L hydrant	N25°W	48.05'
Set Nail & K.C. Remon. tag E. side P. Pole	N30°W	33.34'
C/L manhole cover is 0.25' South of corner		
Manhole at C/L "X" of Bristol & 7th St.		

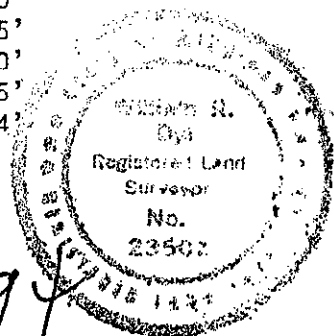

Signed by *W. R. Dyl*
Surveyor's Michigan License No. 23502

Date 11-17-94