

SURVEY & REMONUMENTATION

KENT COUNTY REMONUMENTATION

STATE OF MICHIGAN
COUNTY OF KENT
RECEIVED FOR RECORD

APR 28 1995

LAND CORNER RECORDATION CERTIFICATE

Filing Requirement of Act 74, Mich. P.A. 1970

94 NOV 28 AM 11:49

For corners in **KENT COUNTY**
(County)

Located In:

Corner Code #

- 1. Public Land Survey T 7N R 12W I-10
- T _____ R _____
- T _____ R _____
- T _____ R _____
- 2. Property Controlling S _____ T _____ R _____
- in Section S _____ T _____ R _____
- 3. Miscellaneous S _____ T _____ R _____
- Property in Sec. S _____ T _____ R _____
- 4. Lot No. _____, Recorded Plat _____
- 5. Private Claims _____

Lee J. Bond
REG. OF DEEDS

7344

Register of Deeds Stamp & File Number

I, William R. Byl, in a field survey on May 27, 19 94, do hereby certify that under requirements of P.A. 74, Michigan P.A. of 1970, the corner points mentioned in lines 1 and 2 above were in conformance with regulations and rules therefore as required in the current manual of survey instructions of the United States Department of the Interior, Bureau of Land Management or by a decree of a Court of Law and/or that the corner points mentioned in lines 3, 4 and 5 above were in conformance with the rules of the Michigan Board of Land Surveyors or by a Decree of a Court of Law; established, re-established, monumented, re-monumented, recovered, found as expressed below:

A	B	C	D	E	F	G	H	I	J	K	L	M
2	6	5	4	3	2	1						
3												
4	7	8	9	10	11	12						
5												
6	18	17	16	15	14	13						
7												
8	19	20	21	22	23	24						
9												
10	30	29	28	27	26	25						
11												
12	31	32	33	34	35	36						
13												

NOTE: Not more than 4 corners, all in the same town and range, may be recorded on this certificate.

A. Description of original monument and accessories and/or subsequent restoration:

I-10 1837 GLO Whitcomb Set Post
City of Grand Rapids City Iron
1900-56 Williams & Works City Iron
1962 Kent Co. Wit. MDSH City Iron
1985 LCRC #4256 Byl Set Kent County Monument in mon. box

P.A. 345 1990 KENT COUNTY

PEER APPROVED 11/17/94
CHAIRMAN *Harry K. ...*

The position of this corner was previously approved by the Kent County Remonumentation Peer Group, monumented by William R. Byl on 1/17/85 and was recorded per LCRC #4256

B. Description of corner evidence found and/or method applied in restoring or reestablishing corner:

I-10 Found standard Kent Co. Mon. (Harrison) at N. edge mon. box per witnesses from above LCRC as set by William R. Byl in mon. box he found. City Iron removed during const. of I-196. Said mon. box is in off ramp of I-196. Said mon. box fits plat irons and monuments to West & North.


LCRC #4256

Face of curb (at 90° to ramp) S45°E 13.81'
Face of curb (at 90° to ramp) N45°W 6.85'
C/L reflector post N15°E 22.10'
C/L middle sign post N70°W 13.95'
"+" of Sta. 462+00 E'ly edge E. bound I-196 S60°W 68.58'

The selected location is accepted by me and is generally accepted by professional surveyors as the best available evidence of the position of the original corner.

C. Description of monument for corner and accessories established to perpetuate locating the position of the corner:

I-10 Standard Kent County Monument in mon. box
Face of curb (at 90° to ramp) S45°E 13.81'
Face of curb (at 90° to ramp) N45°W 6.85'
C/L reflector post (different location) N30°E 76.80'
SE cor. E. sign post N00°W 17.09'
"+" of Sta. 462+00 E'ly edge E. bound I-196 S60°W 68.58'
Set Nail & KC Remon. tag N. side 12" Pine S70°E 37.30'

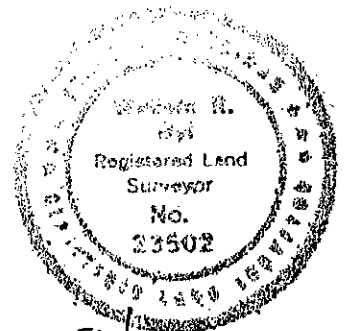

Signed by *W. R. Byl* Date 11-17-94
Surveyor's Michigan License No. 23502