

SURVEY & REMONUMENTATION

KENT COUNTY REMONUMENTATION

APR 28 1995

STATE OF MICHIGAN
COUNTY OF KENT
RECEIVED FOR RECORD

LAND CORNER RECORDATION CERTIFICATE

Filing Requirement of Act 74, Mich. P.A. 1970 ⁹⁴ NOV 28 AM 11:49

COMMISSION

For corners in
KENT COUNTY

(County)	Located In:	Corner Code #
1. Public Land Survey	T <u>7N</u> R <u>12W</u>	<u>I-13</u>
	T _____ R _____	_____
	T _____ R _____	_____
	T _____ R _____	_____
2. Property Controlling in Section	S _____ T _____ R _____	_____
	S _____ T _____ R _____	_____
3. Miscellaneous Property in Sec.	S _____ T _____ R _____	_____
	S _____ T _____ R _____	_____

W. R. Byl
REG. OF DEEDS

7347

Register of Deeds Stamp & File Number

4. Lot No. _____, Recorded Plat _____
5. Private Claims _____

I, William R. Byl, in a field survey on March 29, 19 94, do hereby certify that under requirements of P.A. 74, Michigan P.A. of 1970, the corner points mentioned in lines 1 and 2 above were in conformance with regulations and rules therefore as required in the current manual of survey instructions of the United States Department of the Interior, Bureau of Land Management or by a decree of a Court of Law and/or that the corner points mentioned in lines 3, 4 and 5 above were in conformance with the rules of the Michigan Board of Land Surveyors or by a Decree of a Court of Law; established, re-established, monumented, re-monumented, recovered, found as expressed below:

	A	B	C	D	E	F	G	H	I	J	K	L	M
2	6	5	4	3	2	1							
3													
4	7	8	9	10	11	12							
5													
6	18	17	16	15	14	13							
7													
8	19	20	21	22	23	24							
9													
10	30	29	28	27	26	25							
11													
12	31	32	33	34	35	36							
13													

NOTE: Not more than 4 corners, all in the same town and range, may be recorded on this certificate.

A. Description of original monument and accessories and/or subsequent restoration:

I-13 1831 GLO Lyon Set Post
1893 City of Grand Rapids 5/8" Iron
1894 City of Grand Rapids Measurements in Sec. 35
1930 City of Grand Rapids 2" x 2" Angle Iron
1960 MDSH 2" x 2" Angle Iron
1984 LCRC #4130 Byl Set Kent County Monument

P.A. 345 1990 KENT COUNTY

PEER APPROVED 11/17/94
CHAIRMAN *Harry Huber*

The position of this corner was previously approved by the Kent County Remonumentation Peer Group, monumented by William R. Byl on 11/30/84 and was recorded per LCRC #4130

B. Description of corner evidence found and/or method applied in restoring or reestablishing corner:

I-13 Found standard Kent Co. Mon. (Harrison) per witnesses from above LCRC as set by William R. Byl over top of the 2" x 2" Angle Iron he found. Said 2" x 2" Angle Iron checks with City of Grand Rapids measurements in Sec. 35 (m/1) and MDSH measurements.

LCRC #4130


NE cor. fndn. bldg. #90 (in C&O RR yards)	N15°W	85.07'
SE cor. fndn. bldg. #90	S40°W	38.35'
NW cor. fndn. bldg. #79	S45°W	72.84'
NE cor. fndn. office bldg.	S50°E	130.25'
W'ly side East rail	S90°W	14.38'
E'ly side West rail	N90°E	37.32'
Kent Co. Mon. (I-1 T6N, R12W)	N90°E	96.84'

The selected location is accepted by me and is generally accepted by professional surveyors as the best available evidence of the position of the original corner.

C. Description of monument for corner and accessories established to perpetuate locating the position of the corner:

I-13 Standard Kent County Monument

NE cor. fndn. bldg. #90 (in C&O RR yards)	N15°W	85.07'
SE cor. fndn. bldg. #90	S45°W	38.35'
NW cor. fndn. bldg. #79	S40°W	72.84'
W'ly side East rail	S90°W	14.44'
E'ly side West rail	N90°E	37.41'
Kent Co. Mon. (I-1 T6N, R12W)	N90°E	96.84'

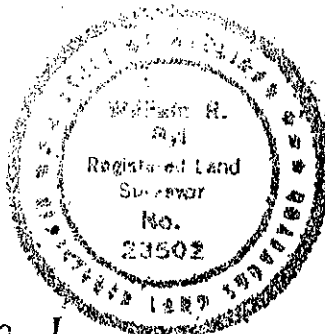

Signed by *W. R. Byl*
Surveyor's Michigan License No. 24502

Date 11-17-94