

**SURVEY & REMONUMENTATION**

APR 28 1995

KENT COUNTY REMONUMENTATION

STATE OF MICHIGAN  
COUNTY OF KENT  
RECEIVED FOR RECORD

**COMMISSION**

**LAND CORNER RECORDATION CERTIFICATE**  
Filing Requirement of Act 74, Mich. P.A. 1970

94 NOV 28 AM 11:49

For corners in  
KENT COUNTY  
(County)

Located In:	Corner Code #
T <u>7N</u> R <u>12W</u>	<u>J-1</u>
T _____ R _____	_____
T _____ R _____	_____
T _____ R _____	_____
T _____ R _____	_____
S _____ T _____ R _____	_____
S _____ T _____ R _____	_____
S _____ T _____ R _____	_____
S _____ T _____ R _____	_____

*W. R. Byl*  
REG. OF DEEDS

**7348**

Register of Deeds Stamp & File Number

4. Lot No. \_\_\_\_\_, Recorded Plat \_\_\_\_\_  
5. Private Claims \_\_\_\_\_

	A	B	C	D	E	F	G	H	I	J	K	L	M
2	6	5	4	3	2	1							
3													
4	7	8	9	10	11	12							
5													
6	18	17	16	15	14	13							
7													
8	19	20	21	22	23	24							
9													
10	30	29	28	27	26	25							
11													
12	31	32	33	34	35	36							
13													

I, William R. Byl, in a field survey on July 27, 19 94, do hereby certify that under requirements of P.A. 74, Michigan P.A. of 1970, the corner points mentioned in lines 1 and 2 above were in conformance with regulations and rules therefore as required in the current manual of survey instructions of the United States Department of the Interior, Bureau of Land Management or by a decree of a Court of Law and/or that the corner points mentioned in lines 3, 4 and 5 above were in conformance with the rules of the Michigan Board of Land Surveyors or by a Decree of a Court of Law; established, re-established, monumented, re-monumented, recovered, found as expressed below:

**NOTE: Not more than 4 corners, all in the same town and range, may be recorded on this certificate.**

A. Description of original monument and accessories and/or subsequent restoration:

P.A. 345 1980 KENT COUNTY

PEER APPROVED 11/17/94  
CHAIRMAN *Harry Huber*

J-1	1837	GLO		Not Set
	1944	Kent Co. Wit.		Concrete Monument
	1975	LCRC #794	Hooth	1/2" Iron in Mon. Box
	1982	LCRC #3153	Hackbardt	Set Kent County Monument
	1990	LCRC #5437	Starr	Kent County Monument
	1992	LCRC #6637	McCloskey	Kent County Monument

The position of this corner was previously approved by the Kent County Remonumentation Peer Group, monumented by Glen S. Hackbardt on 8/5/82 and was recorded per LCRC #3153

B. Description of corner evidence found and/or method applied in restoring or reestablishing corner:

J-1 Found standard Kent Co. Mon. (Harrison) per witnesses from above LCRC as set by Glen S. Hackbardt on Twp. line 0.74' N. of 1/2" Iron he found in a Mon. Box. Said 1/2" Iron in Mon. Box checks with LCRC #794.


LCRC #3153		LCRC #6637	
E'ly cor. CB header	N50°W 57.07'	Nail & KC Remon. tag P. Pole	N05°E 33.48'
NW cor. CB header	N80°E 172.62'	Nail & KC Remon. tag P. Pole	South 49.10'
SW cor. CB header	S80°E 172.47'	E'ly cor. CB header	N50°W 57.07'
C/L MBT Manhole	S15°W 38.06'	NW cor. CB header	N80°E 172.62'
		SW cor. CB header	S80°E 172.47'
		C/L MBT Manhole	S15°W 38.06'
		KC Mon.	West 71.75'
		C/L E-W Bit. Rd. is 1' S.; On fc. line S.	

The selected location is accepted by me and is generally accepted by professional surveyors as the best available evidence of the position of the corner.

C. Description of monument for corner and accessories established to perpetuate locating the position of the corner:

J-1 Standard Kent County Monument

Nail & KC Remon. tag E. side P. Pole	N05°E	33.50'
Nail & KC Remon. tag W. side P. Pole	S00°E	49.10'
E'ly cor. CB header	N50°W	57.07'
NW cor. CB header	N80°E	172.64'
SW cor. CB header	S80°E	172.44'
C/L MBT Manhole	S15°W	38.08'
Kent Co. Mon. (G-13, T8N, R12W)	S90°W	71.75'
C/L E-W Bit. Rd. is 1' S.; On fc. line S; 3/4" Iron in Mon. box is 0.75' South		

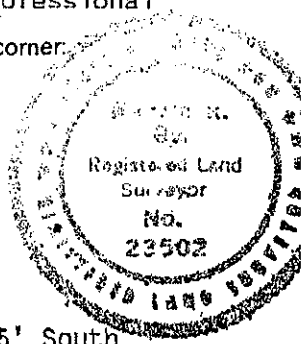

Signed by *W. R. Byl* Date 11-17-94  
Surveyor's Michigan License No. 23502  
FORM APPROVED BY MICHIGAN STATE BOARD OF LAND SURVEYORS, JAN. 28, 1971  
REVISED MAY 14, 1975  
REVISED JAN., 1983