

\$7.00
\$2.00

JAN 24 1996

KENT COUNTY REMONUMENTATION

COMMISSION LAND CORNER RECORDATION CERTIFICATE

Filing Requirement of Act 74, Mich. P.A. 1970

For corners in
KENT COUNTY
(County)

Located In:

Corner Code #

1. Public Land Survey	T	7N	R	12W	J-4
	T		R		
	T		R		
	T		R		
2. Property Controlling in Section	S		T	R	
	S		T	R	
3. Miscellaneous Property in Section	S		T	R	
	S		T	R	

STATE OF MICHIGAN
COUNTY OF KENT
RECEIVED FOR RECORD

95 DEC 26 PM 12:42

REG. OF DEEDS
Lucy Bond

8845

Register of Deeds Stamp & File Number

- 4. Lot No. _____, Recorded Plat _____
- 5. Private Claims _____

A	B	C	D	E	F	G	H	I	J	K	L	M
2	6	5	4	3	2							
3												
4	7	8	9	10	11	12						
5												
6	18	17	16	15	14	13						
7												
8	19	20	21	22	23	24						
9												
10	30	29	28	27	26	25						
11												
12	31	32	33	34	35	36						
13												

I, Kirk BreiteIs, in a field survey on Nov. 15, 19 94

do hereby certify that under requirements of P.A. 74, Michigan P.A. of 1970, the corner points mentioned in lines 1 and 2 above were in conformance with regulations and rules therefore as required in the current manual of survey instructions of the United States Department of the Interior, Bureau of Land Management or by a decree of a Court of Law and/or that the corner points mentioned in lines 3, 4 and 5 above were in conformance with the rules of the Michigan Board of Professional Surveyors or by a Decree of a Court of Law; established, re-established, monumented, re-monumented, recovered, found as expressed below:

NOTE: Not more than 4 corners, all in the same town and range, may be recorded on this certificate.

A. Description of original monument and accessories and/or subsequent restoration:

- J-4 1837 GLO Not Set
- 1911 Williams & Works Center 2645.2' S. of N 1/4 cor. & 2631.4' W. of E 1/4 cor.
- 1947 Williams & Works Iron
- 12" Oak NE 5.9' 9" Oak NE 19.1' 10" Oak W. 15.0' 9" Oak NNE 5.2'
- Kent Co. Wit. Iron
- 12" Oak NW 34.8' 24" Oak NE 40.6' 8" Oak E. 36.3'
- 8" Oak W. 6.5' 8" Oak NE 6.14'
- 1977 Exxel Eng. Iron

B. Description of corner evidence found and/or method applied in restoring or reestablishing corner:


J-4 Found Concrete Monument as indicated on "Alpine Estates No. 14" (Liber 76, Pg. 21 1977) as "Center of Sec. 11." Said Concrete Monument fits remaining witnessess of those above and is 7.7' W. & 1.3' S. from true intersection of 1/4 lines and fits measurements of others.

The Concrete Monument is accepted by me and is generally accepted by professional surveyors as the best available evidence of the position of the corner.

P.A. 345 1990 KENT COUNTY
PEER APPROVED 11/17/94
CHAIRMAN *Harry Hubert*

C. Description of monument for corner and accessories established to perpetuate locating the position of the corner:

- J-4 Set Standard Kent County Monument in place of the Concrete Monument.
- Set Nail & KC Remon. tag N. side 27" Oak S90°W 15.19'
- Set Nail & KC Remon. tag E. side 20" Oak N25°E 5.58'
- Set Nail & KC Remon. tag N. side 27" Oak N90°E 36.14'
- Set Nail & KC Remon. tag NW side 18" Oak S40°W 31.39'
- Set Nail & KC Remon. tag NE side 12" Oak S30°E 46.03'

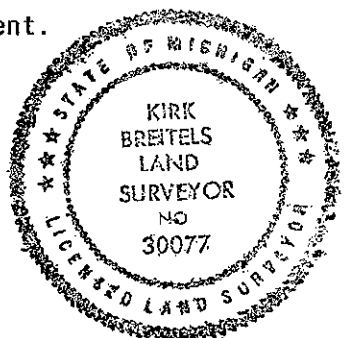

Signed by *Kirk BreiteIs*
Surveyor's Michigan License No. 30077

Date 12/14/95