

**SURVEY & REMONUMENTATION**

APR 28 1995

KENT COUNTY REMONUMENTATION

STATE OF MICHIGAN  
COUNTY OF KENT  
RECEIVED FOR RECORD

**COMMISSION**

**LAND CORNER RECORDATION CERTIFICATE**  
Filing Requirement of Act 74, Mich. P.A. 1970

94 NOV 28 AM 11:49

For corners in

KENT COUNTY

(County)

Located In:

Corner Code #

- |                                    |   |    |   |     |      |
|------------------------------------|---|----|---|-----|------|
| 1. Public Land Survey              | T | 7N | R | 12W | J-11 |
|                                    | T |    | R |     |      |
|                                    | T |    | R |     |      |
|                                    | T |    | R |     |      |
|                                    | T |    | R |     |      |
| 2. Property Controlling in Section | S |    | T | R   |      |
|                                    | S |    | T | R   |      |
| 3. Miscellaneous Property in Sec.  | S |    | T | R   |      |
|                                    | S |    | T | R   |      |
4. Lot No. \_\_\_\_\_, Recorded Plat \_\_\_\_\_
5. Private Claims \_\_\_\_\_

*Twiggland*  
REG. OF DEEDS

7353

Register of Deeds Stamp & File Number

	A	B	C	D	E	F	G	H	I	J	K	L	M
2	6		5		4		3		2		1		
3													
4	7		8		9		10		11		12		
5													
6	18		17		16		15		14		13		
7													
8	19		20		21		22		23		24		
9													
10	30		29		28		27		26		25		
11													
12	31		32		33		34		35		36		
13													

I, William R. Byl, in a field survey on May 27, 1994, do hereby certify that under requirements of P.A. 74, Michigan P.A. of 1970, the corner points mentioned in lines 1 and 2 above were in conformance with regulations and rules therefore as required in the current manual of survey instructions of the United States Department of the Interior, Bureau of Land Management or by a decree of a Court of Law and/or that the corner points mentioned in lines 3, 4 and 5 above were in conformance with the rules of the Michigan Board of Land Surveyors or by a Decree of a Court of Law; established, re-established, monumented, re-monumented, recovered, found as expressed below:

**NOTE: Not more than 4 corners, all in the same town and range, may be recorded on this certificate.**

A. Description of original monument and accessories and/or subsequent restoration:

J-11	1837	GLO	Whitcomb	Set Post	P.A. 345 1990 KENT COUNTY
		City of Grand Rapids		City Iron	PEER APPROVED 11/17/94
		Kent Co. Wit.		City Iron	CHAIRMAN <i>Frank Stuber</i>
1980	LCRC #1352	Bonnema	Pinched Iron		
1982	LCRC #2801	Merdzinski	Set Kent County Monument		
1990	LCRC #5695	Milliron	Kent County Monument		

The position of this corner was previously approved by the Kent County Remonumentation Peer Group, monumented by John A. Merdzinski on 3/24/82 and was recorded per LCRC #2801.

B. Description of corner evidence found and/or method applied in restoring or reestablishing corner:


J-11 Found BROKEN standard Kent Co. Mon. (Harrison) per witnesses from above LCRC as set by John A. Merdzinski in place of the Pinched Iron over a 3/4" Iron he found. Said Irons check with LCRC #1352 and Kent Co. Wit.

LCRC #1352		LCRC #5695	
SW cor. conc. fdn.	N05°E 50.90'	Nail-tag P. Pole	N10°E 46.88'
SE cor. conc. fdn.	N40°E 64.75'	Nail-tag P. pole	S80°E 96.55'
Top N'y cor. contr. struc.	S10°E 84.45'	Chisel. "+" in steel post	S20°E 33.91'
SE cor. RR cross. sign	S20°W 30.50'	Chisel. "+" in steel post	S30°W 56.62'
SE cor. RR cross. sign	West 59.08'	Chisel. "+" in steel post	N60°W 64.31'
C/L RR track	South 17.73'		
C/L blacktop drive is	West 39' m/l		

The selected location is accepted by me and is generally accepted by professional surveyors as the best available evidence of the position of the original corner.

C. Description of monument for corner and accessories established to perpetuate locating the position of the corner:

J-11 Set Standard Kent County Monument in place of remains of broken Kent Co. Mon:	
Nail & KC Remon. E tag E. side P. Pole	N10°E 46.90'
Chiseled "+" in SW side 4" steel post	S20°E 34.08'
Chiseled "+" in E. side 4" steel post (leaning)	S30°W 56.62'
Chiseled "+" in N. side 4" steel post	N60°W 64.31'
E. face of S. gate post	S70°W 65.28'

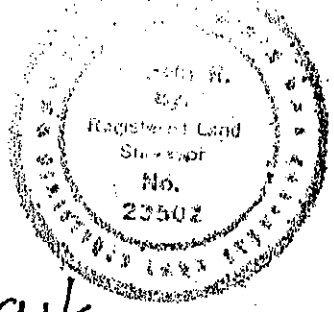

Signed by *W.R. Byl*  
Surveyor's Michigan License No. 23502

Date 11-17-94