

**SURVEY & REMONUMENTATION**

APR 28 1995

KENT COUNTY REMONUMENTATION

STATE OF MICHIGAN  
COUNTY OF KENT  
RECEIVED FOR RECORD

COMMISSION

LAND CORNER RECORDATION CERTIFICATE  
Filing Requirement of Act 74, Mich. P.A. 1970

96 NOV 28 AM 11:49

For corners in  
KENT COUNTY  
(County)

	Located In:	Corner Code #
1. Public Land Survey	T <u>7N</u> R <u>12W</u>	<u>K-1</u>
	T _____ R _____	_____
	T _____ R _____	_____
	T _____ R _____	_____
2. Property Controlling in Section	S _____ T _____ R _____	_____
	S _____ T _____ R _____	_____
3. Miscellaneous Property in Sec.	S _____ T _____ R _____	_____
	S _____ T _____ R _____	_____

*Lucy Bond*  
REG. OF DEEDS

7355

Register of Deeds Stamp & File Number

4. Lot No. \_\_\_\_\_, Recorded Plat \_\_\_\_\_  
5. Private Claims \_\_\_\_\_

I, William R. Byl, in a field survey on June 30, 1994, do hereby certify that under requirements of P.A. 74, Michigan P.A. of 1970, the corner points mentioned in lines 1 and 2 above were in conformance with regulations and rules therefore as required in the current manual of survey instructions of the United States Department of the Interior, Bureau of Land Management or by a decree of a Court of Law and/or that the corner points mentioned in lines 3, 4 and 5 above were in conformance with the rules of the Michigan Board of Land Surveyors or by a decree of a Court of Law; established, re-established, monumented, re-monumented, recovered, found as expressed below:

	A	B	C	D	E	F	G	H	I	J	K	L	M
2	6	5	4	3	2	1							
3													
4	7	8	9	10	11	12							
5													
6	18	17	16	15	14	13							
7													
8	19	20	21	22	23	24							
9													
10	30	29	28	27	26	25							
11													
12	31	32	33	34	35	36							
13													

NOTE: Not more than 4 corners, all in the same town and range, may be recorded on this certificate.

A. Description of original monument and accessories and/or subsequent restoration:

K-1	1837	GLO	Brookfield	Set Post
	1949	Kent Co. Wit.		Boat Spike
	1975	LCRC #793	Hooth	1" Iron in Mon. Box
	1982	LCRC #3153	Hackbardt	Set Kent County Monument
	1990	LCRC #5438	Starr	Kent County Monument
	1992	LCRC #6638	McCloskey	Kent County Monument

P.A. 345 1990 KENT COUNTY  
PEER APPROVED 11/17/94  
CHAIRMAN *[Signature]*

The position of this corner was previously approved by the Kent County Remonumentation Peer Group, monumented by Glen S. Hackbardt on 8/5/82 and was recorded per LCRC #3153

B. Description of corner evidence found and/or method applied in restoring or reestablishing corner:


K-1 Found standard Kent Co. Mon. (Harrison) per witnesses from above LCRC as set by Glen S. Hackbardt on Twp. line 0.84' N. of the 1" Iron he found in a Mon. Box. Said 1" Iron in Mon. Box checks with LCRC #793.

LCRC #3153			LCRC #6638		
SW cor. CB Casing	N10°W	92.57'	SW cor. CB casing	N10°W	92.57'
Harrison Mon.	West	53.87'	SE cor. 1'x1' Gas hand hole	S55°E	33.35'
C/L MBT Manhole	N60°E	75.87'	Nail & KC Remon. tag P. Pole	S45°E	48.97'
NW cor. steel bldg.	S45°E	156.51'	Nail & KC Remon. tag T. Pole	N50°E	40.10'
S. cor. 1'x 1' gas MN	S55°E	33.35'	Nail & KC Remon. tag top S. end guard rail post	North	66.00'
			PK Nail & tag C/L 4 Mile & Alpine	West	35.45'
			KC Mon.	West	75.87'

The selected location is accepted by me and is generally accepted by professional surveyors as the best available evidence of the position of the original corner.

C. Description of monument for corner and accessories established to perpetuate locating the position of the corner:

K-1 Standard Kent County Monument		
SW cor. CB Casing	N10°W	92.61'
SE cor. 1'x1' Gas hand hole	S55°E	33.24'
New Nail & KC Remon. tag NE side P. Pole	S45°E	48.51'
Nail & KC Remon. tag W. side T. Pole	N50°E	40.10'
Nail & KC Remon. tag top S. end guard rail post	N00°E	66.55'
PK Nail & tag C/L 4 Mile & Alpine	S90°W	35.52'
Kent Co. Mon. (K-13, T8N, R12W)	S90°W	75.92'
Iron in Mon. Box	S00°W	0.83'

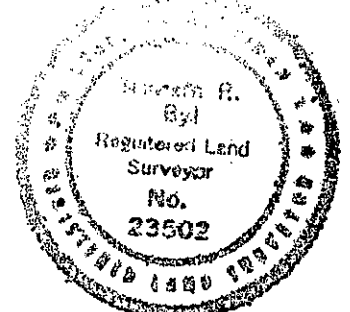

Signed by *[Signature]* Date 11-17-94  
Surveyor's Michigan License No. 23502