

# SURVEY & REMONUMENTATION

KENT COUNTY REMONUMENTATION

STATE OF MICHIGAN  
COUNTY OF KENT  
RECEIVED FOR RECORD

APR 28 1995

LAND CORNER RECORDATION CERTIFICATE  
Filing Requirement of Act 74, Mich. P.A. 1970

94 NOV 28 AM 11:49

For corners in **COMMISSION**  
KENT COUNTY

*David J. Bond*  
REG. OF DEEDS

(County)	Located In:	Corner Code #
1. Public Land Survey	T <u>7N</u> R <u>12W</u>	<u>K-3</u>
	T _____ R _____	_____
	T _____ R _____	_____
	T _____ R _____	_____
2. Property Controlling in Section	S _____ T _____ R _____	_____
	S _____ T _____ R _____	_____
3. Miscellaneous Property in Sec.	S _____ T _____ R _____	_____
	S _____ T _____ R _____	_____
4. Lot No. _____, Recorded Plat _____		
5. Private Claims _____		

**7357**  
Register of Deeds Stamp & File Number

I, William R. Byl, in a field survey on June 6, 19 94, do hereby certify that under requirements of P.A. 74, Michigan P.A. of 1970, the corner points mentioned in lines 1 and 2 above were in conformance with regulations and rules therefore as required in the current manual of survey instructions of the United States Department of the Interior, Bureau of Land Management or by a decree of a Court of Law and/or that the corner points mentioned in lines 3, 4 and 5 above were in conformance with the rules of the Michigan Board of Land Surveyors or by a Decree of a Court of Law; established, re-established, monumented, re-monumented, recovered, found as expressed below:

	A	B	C	D	E	F	G	H	I	J	K	L	M
2	6	5	4	3	2	1							
3													
4	7	8	9	10	11	12							
5													
6	18	17	16	15	14	13							
7													
8	19	20	21	22	23	24							
9													
10	30	29	28	27	26	25							
11													
12	31	32	33	34	35	36							
13													

**NOTE: Not more than 4 corners, all in the same town and range, may be recorded on this certificate.**

A. Description of original monument and accessories and/or subsequent restoration:

K-3	1837	GLO	Whitcomb	Set Post
		Kent Co. Wit.		Mon. Box
	1973	LCRC #524	Spicer	1" Solid Iron in Mon. Box
	1981	LCRC #1849	Tobin	Set Kent County Monument
	1992	LCRC #6634	McCloskey	Kent County Monument

The position of this corner was previously approved by the Kent County Remonumentation Peer Group, monumented by Douglas J. Tobin on 4/1/81 and was recorded per LCRC #1849.

B. Description of corner evidence found and/or method applied in restoring or reestablishing corner:

K-3 Found standard Kent Co. Mon. (Harrison) in mon. box per witnesses from above LCRC as set by Douglas J. Tobin in place of the 1" solid iron in mon. box he found. Said 1" solid iron in mon. box checks with LCRC #524.

LCRC #1849 & 6634

Top C/L hydr.	S40°E	70.60'		
Top C/L hydr.	S50°W	115.40'		
Face 12" metal sign post (Motel Six)	N70°E	114.45'		
Nail & tag in SW side guy pole	N50°W	86.78'		


P.A. 345 1990 KENT COUNTY

PEER APPROVED 11/17/94  
CHAIRMAN David J. Bond

The selected location is accepted by me and is generally accepted by professional surveyors as the best available evidence of the position of the original corner.

C. Description of monument for corner and accessories established to perpetuate locating the position of the corner:

K-3 Standard Kent County Monument in mon. box				
Top C/L hydr.	S40°E	70.18'		
Top C/L hydr.	S50°W	115.47'		
Face 12" metal sign post (Motel Six)	N70°E	114.24'		
SE cor. conc. pad for elec. box	N50°W	105.06'		

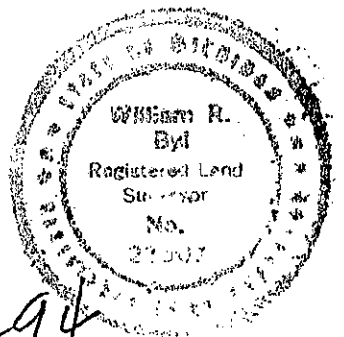

Signed by William R. Byl  
Surveyor's Michigan License No. 23502

Date 11-17-94