

SURVEY & REMONUMENTATION

APR 28 1995

KENT COUNTY REMONUMENTATION

STATE OF MICHIGAN
COUNTY OF KENT
RECEIVED FOR RECORD

LAND CORNER RECORDATION CERTIFICATE Filing Requirement of Act 74, Mich. P.A. 1970

94 NOV 28 AM 11:49

COMMISSION

For corners in
KENT COUNTY

W. J. Bond
REG. OF DEEDS

(County)	Located In:	Corner Code #
1. Public Land Survey	T <u>7N</u> R <u>12W</u>	<u>K-4</u>
	T _____ R _____	_____
	T _____ R _____	_____
	T _____ R _____	_____
2. Property Controlling in Section	S _____ T _____ R _____	_____
	S _____ T _____ R _____	_____
3. Miscellaneous Property in Sec.	S _____ T _____ R _____	_____
	S _____ T _____ R _____	_____
4. Lot No. _____, Recorded Plat _____		
5. Private Claims _____		

7358

Register of Deeds Stamp & File Number

	A	B	C	D	E	F	G	H	I	J	K	L	M
2	6	5	4	3	2	1							
3													
4	7	8	9	10	11	12							
5													
6	18	17	16	15	14	13							
7													
8	19	20	21	22	23	24							
9													
10	30	29	28	27	26	25							
11													
12	31	32	33	34	35	36							
13													

I, William R. Byl, in a field survey on June 6, 19 94, do hereby certify that under requirements of P.A. 74, Michigan P.A. of 1970, the corner points mentioned in lines 1 and 2 above were in conformance with regulations and rules therefore as required in the current manual of survey instructions of the United States Department of the Interior, Bureau of Land Management or by a decree of a Court of Law and/or that the corner points mentioned in lines 3, 4 and 5 above were in conformance with the rules of the Michigan Board of Land Surveyors or by a Decree of a Court of Law; established, re-established, monumented, re-monumented, recovered, found as expressed below:

NOTE: Not more than 4 corners, all in the same town and range, may be recorded on this certificate.

A. Description of original monument and accessories and/or subsequent restoration:

K-4	1837	GLO	Whitcomb	Set Post
	1948	Kent Co. Wit.		Iron Bolt
	1973	LCRC #632	Spicer	Boat spike in mon. box
	1981	LCRC #1844	Shangraw	Set Kent County Monument

The position of this corner was previously approved by the Kent County Remonumentation Peer Group, monumented by Carl F. Shangraw on 5/26/81 and was recorded per LCRC #1844.

B. Description of corner evidence found and/or method applied in restoring or reestablishing corner:

K-4 Found standard Kent Co. Mon. (Harrison) per witnesses from above LCRC as set by Carl F. Shangraw in place of the 1/2" Iron and mon. box he found. Said 1/2" Iron in mon. box checks with LCRC #632.

LCRC #1844

KC Nail & tag in P. Pole	N45°W	63.80'
KC Nail & tag in P/CP Pole	N30°E	66.86'
KC Nail & tag in MBT Pole	S20°E	52.52'
SE cor. conc. base to Lt. Pole	NW	77.77'

P.A. 345 1990 KENT COUNTY.

PEER APPROVED 11/17/94


CHAIRMAN *Harry Shupers*

The selected location is accepted by me and is generally accepted by professional surveyors as the best available evidence of the position of the original corner.

C. Description of monument for corner and accessories established to perpetuate locating the position of the corner:

K-4 Standard Kent County Monument

Nail & KC Remon. tag in P. Pole	N45°W	63.80'
Nail & KC Remon. tag in P. Pole	N30°E	66.86'
C/L top NW bolt of NW beam of skywalk	S25°E	80.16'
Set Nail & KC Remon. tag W. side Lt. Pole	S35°E	62.44'
NE corner of conc. wall	S65°W	65.37'

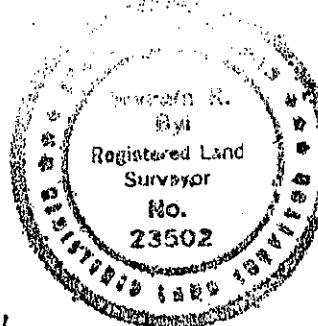

Signed by *W. R. Byl*
Surveyor's Michigan License No. 23502

Date 11-17-94