

**SURVEY & REMONUMENTATION**

APR 28 1995

KENT COUNTY REMONUMENTATION

STATE OF MICHIGAN  
COUNTY OF KENT  
RECEIVED FOR RECORD

COMMISSION

LAND CORNER RECORDATION CERTIFICATE  
Filing Requirement of Act 74, Mich. P.A. 1970

94 NOV 28 AM 11:50

For corners in  
KENT COUNTY  
(County)

Located In: Corner Code #

1. Public Land Survey	T	7N	R	12W	K-6
	T		R		
	T		R		
	T		R		
2. Property Controlling in Section	S		T	R	
	S		T	R	
3. Miscellaneous Property in Sec.	S		T	R	
	S		T	R	

*Lucy Bond*  
REG. OF DEEDS

7360

Register of Deeds Stamp & File Number

4. Lot No. \_\_\_\_\_, Recorded Plat \_\_\_\_\_  
5. Private Claims \_\_\_\_\_

	A	B	C	D	E	F	G	H	I	J	K	L	M
2	6	5	4	3	2	1							
3													
4	7	8	9	10	11	12							
5													
6	18	17	16	15	14	13							
7													
8	19	20	21	22	23	24							
9													
10	30	29	28	27	26	25							
11													
12	31	32	33	34	35	36							
13													

I, William R. Byl, in a field survey on June 6, 1994, do hereby certify that under requirements of P.A. 74, Michigan P.A. of 1970, the corner points mentioned in lines 1 and 2 above were in conformance with regulations and rules therefore as required in the current manual of survey instructions of the United States Department of the Interior, Bureau of Land Management or by a decree of a Court of Law and/or that the corner points mentioned in lines 3, 4 and 5 above were in conformance with the rules of the Michigan Board of Land Surveyors or by a Decree of a Court of Law; established, re-established, monumented, re-monumented, recovered, found as expressed below:

**NOTE: Not more than 4 corners, all in the same town and range, may be recorded on this certificate.**

A. Description of original monument and accessories and/or subsequent restoration:

K-6	1837	GLO	Whitcomb	Set Post
	No date	City of Grand Rapids		City Iron
	1972	LCRC #574	Spicer	Spike over City Iron
	1982	LCRC #2802	Merdzinski	City Iron

The position of this corner was previously approved by the Kent County Remonumentation Peer Group, monumented by John A Merdzinski on 3/19/82 and was recorded per LCRC #2802. (City Iron left in place, Kent County Monument was not set)

B. Description of corner evidence found and/or method applied in restoring or reestablishing corner:

K-6 Found City Iron (4" below road surface) per witnesses from above LCRC as found by John A. Merdzinski. Said City Iron checks with LCRC #574 & #2802.


LCRC #2802

Intersection back of walks	N45°E	43.55'	P.A. 345 1990 KENT COUNTY
NE cor.ner 0.5' conc. curb	S50°W	44.95'	PEER APPROVED 11/17/94
NW cor. brick bldg.	S40°E	51.60'	CHAIRMAN <i>James Huber</i>
SE cor. stone face on bldg.	N40°W	50.73'	(new stone face)
Nail 0.50' W. & 0.40' S. of corner; In centerline of Richmond St. & Alpine Ave.			

The selected location is accepted by me and is generally accepted by professional surveyors as the best available evidence of the position of the original corner.

C. Description of monument for corner and accessories established to perpetuate locating the position of the corner:

K-6 Set Standard Kent County Monument in place of City Iron			
NE cor.ner 0.5' conc. curb	S50°W	44.95'	
NW cor. brick bldg.	S40°E	51.54'	
SE cor. stone face on bldg.	N40°W	50.73'	
Set Nail & KC Remon. tag NW side P. Pole	N60°E	44.00'	
In centerline of Richmond St. & Alpine Ave.			

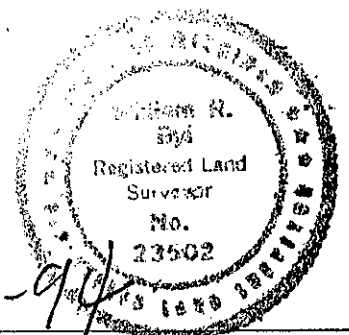

Signed by *William R. Byl*  
Surveyor's Michigan License No. 23502

Date 11-17-94