

SURVEY & REMONUMENTATION

APR 28 1995

KENT COUNTY REMONUMENTATION

STATE OF MICHIGAN
COUNTY OF KENT
RECEIVED FOR RECORD

94 NOV 28 AM 11:50

COMMISSION

LAND CORNER RECORDATION CERTIFICATE
Filing Requirement of Act 74, Mich. P.A. 1970

For corners in
KENT COUNTY
(County)

Located In: Corner Code #

- | | | | | | |
|------------------------------------|---|-----------|---|------------|------------|
| 1. Public Land Survey | T | <u>7N</u> | R | <u>12W</u> | <u>K-7</u> |
| | T | | R | | |
| | T | | R | | |
| | T | | R | | |
| 2. Property Controlling in Section | S | | T | | R |
| | S | | T | | R |
| 3. Miscellaneous Property in Sec. | S | | T | | R |
| | S | | T | | R |

W. R. Byl
REG. OF DEEDS

7361

Register of Deeds Stamp & File Number

4. Lot No. _____, Recorded Plat _____
5. Private Claims _____

A	B	C	D	E	F	G	H	I	J	K	L	M
2	6	5	4	3	2	1						
3												
4	7	8	9	10	11	12						
5												
6	16	17	16	15	14	13						
7												
8	19	20	21	22	23	24						
9												
10	30	29	28	27	26	25						
11												
12	31	32	33	34	35	36						
13												

I, William R. Byl, in a field survey on July 18, 1994, do hereby certify that under requirements of P.A. 74, Michigan P.A. of 1970, the corner points mentioned in lines 1 and 2 above were in conformance with regulations and rules therefore as required in the current manual of survey instructions of the United States Department of the Interior, Bureau of Land Management or by a decree of a Court of Law and/or that the corner points mentioned in lines 3, 4 and 5 above were in conformance with the rules of the Michigan Board of Land Surveyors or by a Decree of a Court of Law; established, re-established, monumented, re-monumented, recovered, found as expressed below:

NOTE: Not more than 4 corners, all in the same town and range, may be recorded on this certificate.

A. Description of original monument and accessories and/or subsequent restoration:

K-7 1837 GLO Whitcomb Set Post
City of Grand Rapids "X" in pavement
1981 LCRC #1331 Byl Set PK Nail from City witnesses
1992 LCRC #6628 Bueche Set Kent Co. Mon. after road const.

The position of this corner was previously approved by the Kent County Remonumentation Peer Group, monumented by John C. Bueche on 11/30/92 and was recorded per LCRC #6628

B. Description of corner evidence found and/or method applied in restoring or reestablishing corner:

K-7 Found standard Kent Co. Mon. (Harrison) per witnesses from above LCRC as set by John C. Bueche after road construction. Said location of Kent Co. Mon. checks with LCRC #1331 and City of Grand Rapids information.


LCRC #6628

SE cor. brick to Old Kent Bank	N45°W	62.37'	P.A. 345 1990 KENT COUNTY
SW cor. conc. wall 1' above walk	N45°E	53.33'	PEER APPROVED 11/17/94
NE cor. brick bldg. @ fnd.	S48°W	45.76'	CHAIRMAN <i>W. R. Byl</i>
NE'y cor. of conc. base of signal box	S45°W	50.09'	
C/L bit. N-S & E-W			

The selected location is accepted by me and is generally accepted by professional surveyors as the best available evidence of the position of the original corner.

C. Description of monument for corner and accessories established to perpetuate locating the position of the corner:

K-7 Standard Kent County Monument
SE cor. brick to Old Kent Bank N45°W 62.53'
SW cor. conc. wall 1' above walk N45°E 53.44'
NE'y cor. of conc. base of signal box S45°W 50.06'
NW cor. column (wood siding) S45°E 45.78'
C/L bit. N-S & E-W

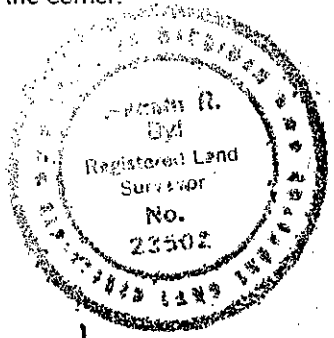

Signed by *W. R. Byl* Date 11-17-94
Surveyor's Michigan License No. 23502