

# SURVEY & REMONUMENTATION

APR 28 1995

## KENT COUNTY REMONUMENTATION

### LAND CORNER RECORDATION CERTIFICATE Filing Requirement of Act 74, Mich. P.A. 1970

STATE OF MICHIGAN  
COUNTY OF KENT  
RECEIVED FOR RECORD  
94 NOV 28 AM 11:50

#### COMMISSION

For corners in  
KENT COUNTY  
(County)

Located In:	Corner Code #
T <u>7N</u> R <u>12W</u>	<u>L-1</u>
T _____ R _____	_____
T _____ R _____	_____
T _____ R _____	_____
S _____ T _____ R _____	_____
S _____ T _____ R _____	_____
S _____ T _____ R _____	_____
S _____ T _____ R _____	_____

*Lucy J. Bond*  
REG. OF DEEDS

7367

Register of Deeds Stamp & File Number

4. Lot No. \_\_\_\_\_, Recorded Plat \_\_\_\_\_  
5. Private Claims \_\_\_\_\_

	A	B	C	D	E	F	G	H	I	J	K	L	M
2	6	5	4	3	2	1							
3													
4	7	8	9	10	11	12							
5													
6	18	17	16	15	14	13							
7													
8	19	20	21	22	23	24							
9													
10	30	29	28	27	26	25							
11													
12	31	32	33	34	35	36							
13													

I, William R. Byl, in a field survey on July 26, 19 94, do hereby certify that under requirements of P.A. 74, Michigan P.A. of 1970, the corner points mentioned in lines 1 and 2 above were in conformance with regulations and rules therefore as required in the current manual of survey instructions of the United States Department of the Interior, Bureau of Land Management or by a decree of a Court of Law and/or that the corner points mentioned in lines 3, 4 and 5 above were in conformance with the rules of the Michigan Board of Land Surveyors or by a Decree of a Court of Law; established, re-established, monumented, re-monumented, recovered, found as expressed below:

**NOTE: Not more than 4 corners, all in the same town and range, may be recorded on this certificate.**

A. Description of original monument and accessories and/or subsequent restoration:

L-1	1837	GLO	Not Set
	1940	Kent Co. Wit.	Steel fence post
	1955	Williams & Works	Conc. Mon.
	1984	LCRC #3855	Kolehouse
	1990	LCRC #5439	Starr
	1992	LCRC #6642	McCloskey
			Set Kent County Monument
			Kent County Monument
			Kent County Monument

P.A. 345 1990 KENT COUNTY  
PEER APPROVED 11/17/94  
CHAIRMAN *Randy J. Kolehouse*

The position of this corner was previously approved by the Kent County Remonumentation Peer Group, monumented by Randy J. Kolehouse on 6/26/84 and was recorded per LCRC #3855

B. Description of corner evidence found and/or method applied in restoring or reestablishing corner:

L-1 Found standard Kent Co. Mon. (Harrison) per witnesses from above LCRC as set by Randy J. Kolehouse in place of the 1" Iron he found. Said 1" Iron checks with Kent Co. Wit. and Williams & Works information.


LCRC #3855	LCRC #6642
Nail & tag P. Pole	North 80.65'
Nail & tag 12" Poplar	N60°E 29.34'
NE cor. CB	S15°W 44.22'
NW cor. CB	S15°E 43.87'
C/L 8" Maple	N30°W 40.35'
KC Mon. at S 1/4 36-8-12	West 35.4'

same witnesses as LCRC #3855 & #5439

The selected location is accepted by me and is generally accepted by professional surveyors as the best available evidence of the position of the corner.

C. Description of monument for corner and accessories established to perpetuate locating the position of the corner:

L-1 Standard Kent County Monument	
Nail & KC Remon. tag E. side P. Pole	N00°E 80.62'
New Nail & KC Remon. tag W. side 16" Poplar	N60°E 29.40'
NE cor. Catch Basin	S15°W 44.22'
NW cor. Catch Basin	S15°E 43.87'
C/L 12" Maple	N30°W 40.45'
KC Mon. at S 1/4 36-8-12	N90°W 35.40'
C/L Dakota St. is East 1'; On tree Tow East	

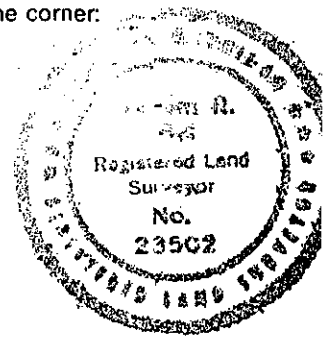

Signed by *William R. Byl*  
Surveyor's Michigan License No. 23502

Date 11-17-94