

SURVEY & REMONUMENTATION

APR 28 1995

KENT COUNTY REMONUMENTATION

STATE OF MICHIGAN
COUNTY OF KENT
RECEIVED FOR RECORD

COMMISSION

LAND CORNER RECORDATION CERTIFICATE

Filing Requirement of Act 74, Mich. P.A. 1970

94 NOV 28 AM 11:50

For corners in
KENT COUNTY
(County)

Located In: Corner Code #

1. Public Land Survey	T	<u>7N</u>	R	<u>12W</u>	<u>L-3</u>
	T		R		
	T		R		
	T		R		
2. Property Controlling in Section	S		T		R
	S		T		R
3. Miscellaneous Property in Sec.	S		T		R
	S		T		R

W. J. Bond
REG. OF DEEDS

7368

Register of Deeds Stamp & File Number

4. Lot No. _____, Recorded Plat _____
5. Private Claims _____

	A	B	C	D	E	F	G	H	I	J	K	L	M
2	6	5	4	3	2	1							
3													
4	7	8	9	10	11	12							
5													
6	18	17	16	15	14	13							
7													
8	19	20	21	22	23	24							
9													
10	30	29	28	27	26	25							
11													
12	31	32	33	34	35	36							
13													

I, William R. Byl, in a field survey on April 22, 19 93, do hereby certify that under requirements of P.A. 74, Michigan P.A. of 1970, the corner points mentioned in lines 1 and 2 above were in conformance with regulations and rules therefore as required in the current manual of survey instructions of the United States Department of the Interior, Bureau of Land Management or by a decree of a Court of Law and/or that the corner points mentioned in lines 3, 4 and 5 above were in conformance with the rules of the Michigan Board of Land Surveyors or by a Decree of a Court of Law; established, re-established, monumented, re-monumented, recovered, found as expressed below:

NOTE: Not more than 4 corners, all in the same town and range, may be recorded on this certificate.

A. Description of original monument and accessories and/or subsequent restoration:

L-3	1837	GLO	Whitcomb	Set Post	P.A. 345 1990 KENT COUNTY
		Kent Co. Wit.		1" Iron Bar	PEER APPROVED 11/17/94
	1961, 1985	Williams & Works		"T" Iron	CHAIRMAN <i>Randy J. Kolehouse</i>
	1972	LCRC #329	Spicer	1" Iron	
	1982	LCRC #2714	Stadt	"L-3 per LCRC #329 is incorrect"	
	1985	LCRC #4309	Kolehouse	Set Kent County Monument	

The position of this corner was previously approved by the Kent County Remonumentation Peer Group, monumented by Randy J. Kolehouse on 8/19/85 and was recorded per LCRC #4309

B. Description of corner evidence found and/or method applied in restoring or reestablishing corner:

L-3 Found standard Kent Co. Mon. (Harrison) per witnesses from above LCRC as set by Randy J. Kolehouse in place of the "T" Iron he found. Said "T" Iron checks with Williams & Works and MDSH survey data for I-96 & US-131.


LCRC #4309

Face of steel light pole	S45°E	11.3'
PK in top C/L wood guard rail post	N85°E	4.35'
PK in top C/L wood guard rail post	North	4.15'
W'ly edge conc. pavement	East	24.4'
W'ly edge conc. pavement	N45°E	13.75'
"T" iron (on section line)	N90°W	197.35'

The selected location is accepted by me and is generally accepted by professional surveyors as the best available evidence of the position of the original corner.

C. Description of monument for corner and accessories established to perpetuate locating the position of the corner:

L-3 Standard Kent County Monument		
Face of steel light pole	S45°E	11.3'
PK in top C/L wood guard rail post	N85°E	4.35'
PK in top C/L wood guard rail post	North	4.15'
W'ly edge conc. pavement	East	24.4'
W'ly edge conc. pavement	N45°E	13.75'
"T" iron (on section line)	N90°W	197.35'
(did not check line on "T" iron)		

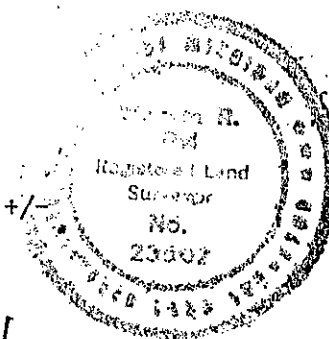

Signed by *W. R. Byl* Date 11-17-94

Surveyor's Michigan License No. 23502 11-17-94