

SURVEY & REMONUMENTATION

APR 28 1995

KENT COUNTY REMONUMENTATION

STATE OF MICHIGAN
COUNTY OF KENT
RECEIVED FOR RECORD

COMMISSION

LAND CORNER RECORDATION CERTIFICATE
Filing Requirement of Act 74, Mich. P.A. 1970

94 NOV 28 AM 11:50

For corners in
KENT COUNTY

Located In: Corner Code #

- | | | |
|------------------------------------|--------------------------|------------|
| 1. Public Land Survey | T <u>7N</u> R <u>12W</u> | <u>L-7</u> |
| | T _____ R _____ | _____ |
| | T _____ R _____ | _____ |
| | T _____ R _____ | _____ |
| 2. Property Controlling in Section | S _____ T _____ R _____ | _____ |
| | S _____ T _____ R _____ | _____ |
| 3. Miscellaneous Property in Sec. | S _____ T _____ R _____ | _____ |
| | S _____ T _____ R _____ | _____ |

Lucy Bond
REG. OF DEEDS

7370

Register of Deeds Stamp & File Number

4. Lot No. _____, Recorded Plat _____
5. Private Claims _____

A	B	C	D	E	F	G	H	I	J	K	L	M
2	6	5	4	3	2	1						
3												
4	7	8	9	10	11	12						
5												
6	18	17	16	15	14	13						
7												
8	19	20	21	22	23	24						
9												
10	30	29	28	27	26	25						
11												
12	31	32	33	34	35	36						
13												

I, William R. Bvl, in a field survey on June 30, 19 94, do hereby certify that under requirements of P.A. 74, Michigan P.A. of 1970, the corner points mentioned in lines 1 and 2 above were in conformance with regulations and rules therefore as required in the current manual of survey instructions of the United States Department of the Interior, Bureau of Land Management or by a decree of a Court of Law and/or that the corner points mentioned in lines 3, 4 and 5 above were in conformance with the rules of the Michigan Board of Land Surveyors or by a Decree of a Court of Law; established, re-established, monumented, re-monumented, recovered, found as expressed below:

NOTE: Not more than 4 corners, all in the same town and range, may be recorded on this certificate.

A. Description of original monument and accessories and/or subsequent restoration:

L-7	1837	GLO	Whitcomb	Set Post
		City of Grand Rapids		Witnesses to corner given
	1992	LCRC #6629	Bueche	Set Kent County Monument after road construction.

The position of this corner was previously approved by the Kent County Remonumentation Peer Group, monumented by John C. Bueche on 11/30/92 and was recorded per LCRC #6629

B. Description of corner evidence found and/or method applied in restoring or reestablishing corner:

L-7 Found standard Kent Co. Mon. (Harrison) per witnesses from above LCRC as set by John C. Bueche after road construction. Said location of Kent Co. Mon. checks with City of Grand Rapids witnesses and adjacent plats.

LCRC #6629

SW cor. brick bldg.	NW	51.32'
SE cor. brick bldg.	N	33.17'
NE cor. bldg.	SW	45.71'
C/L SW bolt to sign	S40°E	57.20'
On C/L Bit. Rd. E-W		

P.A. 345 1990 KENT COUNTY

PEER APPROVED 11/17/94


CHAIRMAN *Harry Huber*

The selected location is accepted by me and is generally accepted by professional surveyors as the best available evidence of the position of the original corner.

C. Description of monument for corner and accessories established to perpetuate locating the position of the corner:

L-7 Standard Kent County Monument

SW cor. brick bldg.	N45°W	51.34'	
SE cor. brick bldg.	N00°E	33.23'	(33.17' to fnd.)
NE cor. brick bldg.	S45°W	45.67'	
C/L SW bolt to sign	S40°E	57.27'	
On C/L Bit. Rd. E-W			

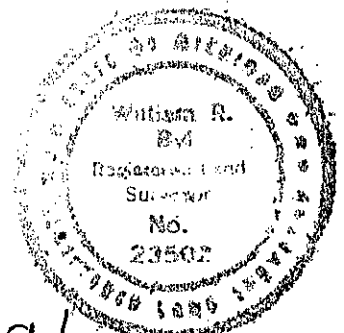

Signed by *W. R. Bvl*
Surveyor's Michigan License No. 23502

Date 11-17-94