

SURVEY & REMONUMENTATION

KENT COUNTY REMONUMENTATION

SEP 03 1999

LAND CORNER RECORDATION CERTIFICATE

Filing Requirement of Act 74, Mich. P.A. 1970

SECTION

For corners in
KENT COUNTY
(County)

Located In:

Corner Code #

- | | | | | | |
|--------------------------------------|---|-----------|---|------------|------------|
| 1. Public Land Survey | T | <u>7N</u> | R | <u>12W</u> | <u>L-8</u> |
| | T | | R | | |
| | T | | R | | |
| | T | | R | | |
| 2. Property Controlling in Section | S | | T | R | |
| | S | | T | R | |
| 3. Miscellaneous Property in Section | S | | T | R | |
| | S | | T | R | |

REG. OF DEEDS

Lucy Bond

95 DEC 26 PM 12:43

STATE OF MICHIGAN
COUNTY OF KENT
RECEIVED FOR RECORD

8858

Register of Deeds Stamp & File Number

4. Lot No. _____, Recorded Plat _____
5. Private Claims _____

I, Kirk Breitels, in a field survey on Dec. 15, 1994, do hereby certify that under requirements of P.A. 74, Michigan P.A. of 1970, the corner points mentioned in lines 1 and 2 above were in conformance with regulations and rules therefore as required in the current manual of survey instructions of the United States Department of the Interior, Bureau of Land Management or by a decree of a Court of Law and/or that the corner points mentioned in lines 3, 4 and 5 above were in conformance with the rules of the Michigan Board of Professional Surveyors or by a Decree of a Court of Law; established, re-established, monumented, re-monumented, recovered, found as expressed below:

NOTE: Not more than 4 corners, all in the same town and range, may be recorded on this certificate.

| | A | B | C | D | E | F | G | H | I | J | K | L | M |
|----|----|---|----|---|----|---|----|---|----|---|----|---|---|
| 2 | 6 | | 5 | | 4 | | 3 | | 2 | | 1 | | |
| 3 | | | | | | | | | | | | | |
| 4 | 7 | | 8 | | 9 | | 10 | | 11 | | 12 | | |
| 5 | | | | | | | | | | | | | |
| 6 | 13 | | 17 | | 16 | | 15 | | 14 | | 13 | | |
| 7 | | | | | | | | | | | | | |
| 8 | 19 | | 20 | | 21 | | 22 | | 23 | | 24 | | |
| 9 | | | | | | | | | | | | | |
| 10 | 30 | | 29 | | 28 | | 27 | | 26 | | 25 | | |
| 11 | | | | | | | | | | | | | |
| 12 | 31 | | 32 | | 33 | | 34 | | 35 | | 36 | | |
| 13 | | | | | | | | | | | | | |

A. Description of original monument and accessories and/or subsequent restoration:

L-8 1837 GLO Not Set
No information, never set or used.

P.A. 345 1990 KENT COUNTY
PEER APPROVED 12/13/94
CHAIRMAN [Signature]

B. Description of corner evidence found and/or method applied in restoring or reestablishing corner:


L-8 Established position of corner by intersecting a line between the North and South 1/4 corners (N-S 1/4 line) of Section 24 and a line from the West 1/4 corner of Section 24 running Easterly on the E-W 1/4 line per plats (also centerline of 7th St. per improvements).

The position as described above is accepted by me and is generally accepted by professional surveyors as the best available evidence of the position of the corner.

C. Description of monument for corner and accessories established to perpetuate locating the position of the corner:

L-8 Set Standard Kent County Witness Monument 50.54' West (on C/L 7th St. per improvements) of established position of corner.

- | | | |
|--|-------|--------|
| Set Nail & KC Remon. tag SW side Lt. Pole | N60°W | 52.80' |
| Set Nail & KC Remon. tag E. side P. Pole | N00°E | 60.81' |
| Set Nail & KC Remon. tag NW side 12" Maple | N65°E | 17.48' |
| Set Nail & KC Remon. tag E. side P. Pole | S00°W | 64.67' |
| C/L top fire hydrant | S45°W | 55.72' |
| Face curb - West 2.9' | | |

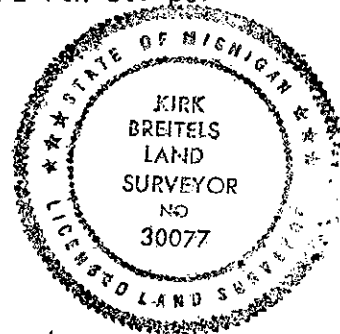

Signed by [Signature]
30077
Surveyor's Michigan License No. _____

Date 12/14/95