

**SURVEY & REMONUMENTATION**

APR 28 1995

KENT COUNTY REMONUMENTATION

STATE OF MICHIGAN  
COUNTY OF KENT  
RECEIVED FOR RECORD

94 NOV 28 AM 11:50

**LAND CORNER RECORDATION CERTIFICATE**  
Filing Requirement of Act 74, Mich. P.A. 1970

**COMMISSION**

For corners in  
KENT COUNTY

(County)

Located In:

Corner Code #

1. Public Land Survey	T <u>7N</u> R <u>12W</u>	<u>L-9</u>
	T _____ R _____	_____
	T _____ R _____	_____
	T _____ R _____	_____
2. Property Controlling in Section	S _____ T _____ R _____	_____
	S _____ T _____ R _____	_____
3. Miscellaneous Property in Sec.	S _____ T _____ R _____	_____
	S _____ T _____ R _____	_____

*Luigi Bond*  
REG. OF DEEDS

**7371**

Register of Deeds Stamp & File Number

4. Lot No. \_\_\_\_\_, Recorded Plat \_\_\_\_\_  
5. Private Claims \_\_\_\_\_

A	B	C	D	E	F	G	H	I	J	K	L	M
2	6	5	4	3	2	1						
3												
4	7	8	9	10	11	12						
5												
6	18	17	16	15	14	13						
7												
8	19	20	21	22	23	24						
9												
10	30	29	28	27	26	25						
11												
12	31	32	33	34	35	36						
13												

I, William R. Byl, in a field survey on May 23, 19 94, do hereby certify that under requirements of P.A. 74, Michigan P.A. of 1970, the corner points mentioned in lines 1 and 2 above were in conformance with regulations and rules therefore as required in the current manual of survey instructions of the United States Department of the Interior, Bureau of Land Management or by a decree of a Court of Law and/or that the corner points mentioned in lines 3, 4 and 5 above were in conformance with the rules of the Michigan Board of Land Surveyors or by a Decree of a Court of Law; established, re-established, monumented, re-monumented, recovered, found as expressed below:

**NOTE: Not more than 4 corners, all in the same town and range, may be recorded on this certificate.**

**A. Description of original monument and accessories and/or subsequent restoration:**

L-9	1837	GLO	Whitcomb	Set Post
		Williams & Works		Possible City Iron
		Kent Co. Wit.		"Cut"
		Moore & Bruggink		PK Nail
	1991	LCRC #5865	Bueche	Set Kent County Monument
	1991	LCRC #6188	McCloskey	Set Kent County Monument after const.

P.A. 345 1990 KENT COUNTY  
PEER APPROVED 11/17/94  
CHAIRMAN *[Signature]*

The position of this corner was previously approved by the Kent County Remonumentation Peer Group, monumented by John C. Bueche on 5/13/91 and was recorded per LCRC #5865. Remonumented by J. Patrick McCloskey on 9/5/91 and was recorded per LCRC #6188.

**B. Description of corner evidence found and/or method applied in restoring or reestablishing corner:**

L-9 Found standard Kent Co. Mon. (Harrison) per witnesses from above LCRC as set by John C. Bueche in place of the PK Nail he found and remonumented by J. Patrick McCloskey. Said PK Nail checks with prev. information from Moore & Bruggink and MDSH.


<u>LCRC #5865</u>	NE cor. CB header	S55°E	49.70'	<u>LCRC #6188</u>	NE cor. frwy. pillar (E'ly cor.)	N12°W	52.24'
	NE face pillar	S40°W	51.70'		SE cor. frwy. pillar (E'ly cor.)	S32°W	55.10'
	SE face pillar	N15°E	49.16'		NW cor. frwy. pillar (N'ly cor.)	S56°W	73.48'
	SW face Signal Pole	N60°E	53.71'		S. cor. frwy. pillar	N68°W	119.67'
	NW face Lt. Pole	S20°E	51.01'		Top C/L hydrant	N66°E	67.91'
	C/L "X" Bridge & Scribner						

The selected location is accepted by me and is generally accepted by professional surveyors as the best available evidence of the position of the original corner.

**C. Description of monument for corner and accessories established to perpetuate locating the position of the corner:**

L-9 Standard Kent County Monument

NE cor. CB header	S55°E	49.70'
NE face pillar	S40°W	51.80'
SE face pillar	N15°W	49.16'
SW face Signal Pole	N60°E	53.66'
NW face Lt. Pole	S20°E	51.18'
C/L "X" Bridge & Scribner		

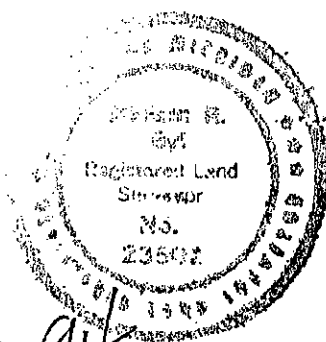

Signed by *[Signature]* Date 11-17-94  
Surveyor's Michigan License No. 23502 ~~11-17-94~~