

SURVEY & REMONUMENTATION

APR 28 1995

KENT COUNTY REMONUMENTATION

STATE OF MICHIGAN
COUNTY OF KENT
RECEIVED FOR RECORD

COMMISSION

LAND CORNER RECORDATION CERTIFICATE
Filing Requirement of Act 74, Mich. P.A. 1970

94 NOV 28 AM 11:50

For corners in
KENT COUNTY
(County)

Located In: Corner Code #

- | | | | | | |
|------------------------------------|---|----|---|-----|------|
| 1. Public Land Survey | T | 7N | R | 12W | L-13 |
| | T | | R | | |
| | T | | R | | |
| | T | | R | | |
| 2. Property Controlling in Section | S | | T | R | |
| | S | | T | R | |
| 3. Miscellaneous Property in Sec. | S | | T | R | |
| | S | | T | R | |

W. R. Byl
REG. OF DEEDS

7373

Register of Deeds Stamp & File Number

4. Lot No. _____, Recorded Plat _____
5. Private Claims _____

	A	B	C	D	E	F	G	H	I	J	K	L	M
2	6	5	4	3	2	1							
3													
4	7	8	9	10	11	12							
5													
6	13	17	16	15	14	13							
7													
8	19	20	21	22	23	24							
9													
10	30	29	28	27	26	25							
11													
12	31	32	33	34	35	36							
13													

I, William R. Byl, in a field survey on March 29, 1994, do hereby certify that under requirements of P.A. 74, Michigan P.A. of 1970, the corner points mentioned in lines 1 and 2 above were in conformance with regulations and rules therefore as required in the current manual of survey instructions of the United States Department of the Interior, Bureau of Land Management or by a decree of a Court of Law and/or that the corner points mentioned in lines 3, 4 and 5 above were in conformance with the rules of the Michigan Board of Land Surveyors or by a Decree of a Court of Law; established, re-established, monumented, re-monumented, recovered, found as expressed below:

NOTE: Not more than 4 corners, all in the same town and range, may be recorded on this certificate.

A. Description of original monument and accessories and/or subsequent restoration:

L-13	1831	GLO	Lyon	Set Post
	1912-1957	Williams & Works		City Iron-Nail
		City of Grand Rapids		Dimensions given
		MDSH R/W Books		Dimensions & bearings given
	1985	LCRC #4128	Byl	Set Kent County Monument

The position of this corner was previously approved by the Kent County Remonumentation Peer Group, monumented by William R. Byl on 11/28/84 and recorded per LCRC #4128

B. Description of corner evidence found and/or method applied in restoring or reestablishing corner:

L-13 Found standard Kent Co. Mon. (Harrison) per witnesses from above LCRC as set by William R. Byl in place of the 1" Iron Bar he found in a Mon. Box in C/L US-131 exit ramp. Said 1" Iron Bar checks with Williams & Works and MDSH measurements.

LCRC #4128

"V" cut in face, W. side light pole (conc.)	N80°E	60.65'
"V" cut in face, S. side light pole (conc.)	N20°W	61.70'
NW face 8" (steel) light pole	S55°E	36.16'
E. face 12" (steel) light pole	S70°W	54.58'
Nail & tag W. side Power Pole	S40°W	61.59'
Kent Co. Mon. (N 1/4 Sec. 1)	N90°E	35.14'


P.A. 345 1990 KENT COUNTY.

PEER APPROVED 11/17/94
CHAIRMAN Harry Huber

The selected location is accepted by me and is generally accepted by professional surveyors as the best available evidence of the position of the original corner.

C. Description of monument for corner and accessories established to perpetuate locating the position of the corner:

L-13 Standard Kent County Monument		
NW face 8" (steel) light pole	S55°E	36.16'
E. face 12" (steel) light pole	S70°W	54.58'
Nail & tag W. side Power Pole	S40°W	61.59'
SW cor. conc. base of Guy Pole	N40°E	114.59'
"X" cut top most E/ly bolt Hwy. sign base	N30°W	71.11'
Kent Co. Mon. (N 1/4 Sec. 6-6-12)	N90°E	35.14'

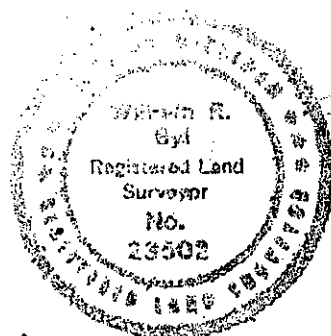

Signed by W. R. Byl
Surveyor's Michigan License No. 23502

Date 11-17-94