

\$7.00 SEP 18 1995
\$2.00 COMMISSION

KENT COUNTY REMONUMENTATION

LAND CORNER RECORDATION CERTIFICATE
Filing Requirement of Act 74, Mich. P.A. 1970

For corners in KENT COUNTY (County) Located In: _____ Corner Code # _____

1. Public Land Survey	T <u>7N</u> R <u>12W</u>	M-2
	T _____ R _____	_____
	T _____ R _____	_____
	T _____ R _____	_____
2. Property Controlling in Section	S _____ T _____ R _____	_____
	S _____ T _____ R _____	_____
3. Miscellaneous Property in Section	S _____ T _____ R _____	_____
	S _____ T _____ R _____	_____

4. Lot No. _____, Recorded Plat _____
5. Private Claims _____

STATE OF MICHIGAN
COUNTY OF KENT
RECEIVED FOR RECORD
95 JUN 29 AM 11:50
REG. OF DEEDS
8416
Register of Deeds Stamp & File Number

I, Kirk Breitels, in a field survey on March 28, 19 95, do hereby certify that under requirements of P.A. 74, Michigan P.A. of 1970, the corner points mentioned in lines 1 and 2 above were in conformance with regulations and rules therefore as required in the current manual of survey instructions of the United States Department of the Interior, Bureau of Land Management or by a decree of a Court of Law and/or that the corner points mentioned in lines 3, 4 and 5 above were in conformance with the rules of the Michigan Board of Professional Surveyors or by a Decree of a Court of Law; established, re-established, monumented, re-monumented, recovered, found as expressed below:

A	B	C	D	E	F	G	H	I	J	K	L	M
2	6	5	4	3	2	1						
3												
4	7	8	9	10	11	12						
5												
6	18	17	16	15	14	13						
7												
8	19	20	21	22	23	24						
9												
10	30	29	28	27	26	25						
11												
12	31	32	33	34	35	36						
13												

NOTE: Not more than 4 corners, all in the same town and range, may be recorded on this certificate.

A. Description of original monument and accessories and/or subsequent restoration:

M-2	1831	GLO	Lyon	Set Post
	1893	Williams & Works		Iron
	1928	Kent Co. Wit.		Iron
	1958		Reda	Iron - data for US-16 (I-96)

B. Description of corner evidence found and/or method applied in restoring or reestablishing corner:

M-2 Established location per MDSH information for I-96 (Right-of-Way book). Said location agrees with 1958 information by Reda by 0.3' m/l and 00°02' m/l.


The selected location is accepted by me and is generally accepted by professional surveyors as the best available evidence of the position of the original corner.

P.A. 345 1990 KENT COUNTY
PEER APPROVED 3/30/95
CHAIRMAN Harry Huber

C. Description of monument for corner and accessories established to perpetuate locating the position of the corner:

M-2 Set Standard Kent County Monument (Harrison) at location as described in "B" above.

Set Nail & KC Remon. tag top guard rail post	S50°W	53.64'
Set Nail & KC Remon. tag top guard rail post	S00°W	23.24'
Set Nail & KC Remon. tag top guard rail post	S85°E	54.48'
Top W. bolt W. pillar S. side sign structure	N65°E	178.06'
Top W. bolt W. pillar N. side sign structure	N45°E	203.36'
Set Nail & KC Remon. tag SW side 15" Pine	N55°W	223.84'
S. edge W. bound I-96 (conc.) pavement	N20°W	38.69'
N. edge E. bound I-96 (conc.) pavement	S20°E	31.43'

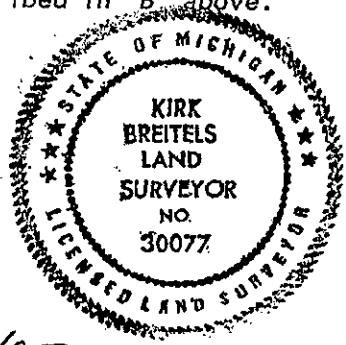

Signed by Kirk Breitels Date 6/26/95
Surveyor's Michigan License No. 30077