

**SURVEY & REMONUMENTATION**

APR 28 1995

KENT COUNTY REMONUMENTATION

STATE OF MICHIGAN  
COUNTY OF KENT  
RECEIVED FOR RECORD

COMMISSION

LAND CORNER RECORDATION CERTIFICATE  
Filing Requirement of Act 74, Mich. P.A. 1970

94 NOV 28 AM 11:50

For corners in  
KENT COUNTY  
(County)

Located in: Corner Code #

- |                                    |                          |            |
|------------------------------------|--------------------------|------------|
| 1. Public Land Survey              | T <u>7N</u> R <u>12W</u> | <u>M-4</u> |
|                                    | T _____ R _____          | _____      |
|                                    | T _____ R _____          | _____      |
|                                    | T _____ R _____          | _____      |
| 2. Property Controlling in Section | S _____ T _____ R _____  | _____      |
|                                    | S _____ T _____ R _____  | _____      |
| 3. Miscellaneous Property in Sec.  | S _____ T _____ R _____  | _____      |
|                                    | S _____ T _____ R _____  | _____      |

*W. J. Bond*  
REG. OF DEEDS

7376

Register of Deeds Stamp & File Number

4. Lot No. \_\_\_\_\_, Recorded Plat \_\_\_\_\_  
5. Private Claims \_\_\_\_\_

A	B	C	D	E	F	G	H	I	J	K	L	M
2	6	5	4	3	2	1						
3												
4	7	8	9	10	11	12						
5												
6	10	17	16	15	14	13						
7												
8	19	20	21	22	23	24						
9												
10	30	29	28	27	26	25						
11												
12	31	32	33	34	35	36						
13												

I, William R. Byl, in a field survey on April 12, 19 93, do hereby certify that under requirements of P.A. 74, Michigan P.A. of 1970, the corner points mentioned in lines 1 and 2 above were in conformance with regulations and rules therefore as required in the current manual of survey instructions of the United States Department of the Interior, Bureau of Land Management or by a decree of a Court of Law and/or that the corner points mentioned in lines 3, 4 and 5 above were in conformance with the rules of the Michigan Board of Land Surveyors or by a Decree of a Court of Law; established, re-established, monumented, re-monumented, recovered, found as expressed below:

**NOTE: Not more than 4 corners, all in the same town and range, may be recorded on this certificate.**

A. Description of original monument and accessories and/or subsequent restoration:

M-4	1831	GLO	Lyon	Set Post
		City of Grand Rapids		Iron
		Kent Co. Wit.		Iron
	1985	LCRC #4250	Byl	Set Kent County Monument

P.A. 345 1900 KENT COUNTY

PEER APPROVED 11/17/94  
CHAIRMAN *Harry Stuber*

The position of this corner was previously approved by the Kent County Remonumentation Peer Group, monumented by William R. Byl on 6/11/85 and was recorded per LCRC #4250

B. Description of corner evidence found and/or method applied in restoring or reestablishing corner:

M-4 Found standard Kent Co. Mon. (Harrison) per witnesses from above LCRC as set by William R. Byl in place of the 1" Iron Pipe he found. Said 1" Iron Pipe checks with City of Grand Rapids information and adjoining plats.

LCRC #4250


Nail & tag E. side 24" Cottonwood	N00°E	6.55'
Nail & tag W. side 27" Twin Cottonwood	N55°E	76.80'
Nail & tag N. side 36" Cottonwood	S70°E	53.69'
Nail & tag N. side 30" Cottonwood	S45°W	30.50'
Kent Co. Monument @ W 1/4 cor. Sec. 7, T7N, R11W	N00°E	10.56'

The selected location is accepted by me and is generally accepted by professional surveyors as the best available evidence of the position of the original corner.

C. Description of monument for corner and accessories established to perpetuate locating the position of the corner:

M-4 Standard Kent County Monument

New Nail & K.C. Remon. tag E. side 24" Cottonwood	N00°E	6.57'
New Nail & K.C. Remon. tag W. side 30" Twin Cottonwood	N55°E	76.82'
New Nail & K.C. Remon. tag N. side 42" Cottonwood	S70°E	53.70'
New Nail & K.C. Remon. tag N. side 33" Cottonwood	S45°W	30.48'
Kent Co. Monument @ W 1/4 cor. Sec. 7, T7N, R11W	N00°E	10.56'

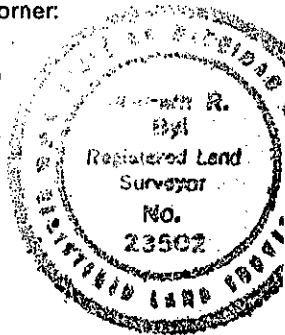

Signed by *W. R. Byl* Date 11-17-94  
Surveyor's Michigan License No. 23502