

**SURVEY & REMONUMENTATION**

APR 28 1995

KENT COUNTY REMONUMENTATION

STATE OF MICHIGAN  
COUNTY OF KENT  
RECEIVED FOR RECORD

**COMMISSION**

**LAND CORNER RECORDATION CERTIFICATE** NOV 28 AM 11:50  
Filing Requirement of Act 74, Mich. P.A. 1970

For corners in  
KENT COUNTY  
(County)

Located In:	Corner Code #
T <u>7N</u> R <u>12W</u>	<u>M-5</u>
T _____ R _____	_____
T _____ R _____	_____
T _____ R _____	_____
S _____ T _____ R _____	_____
S _____ T _____ R _____	_____
S _____ T _____ R _____	_____
S _____ T _____ R _____	_____

*Lucy Bond*  
REG. OF DEEDS

**7377**

Register of Deeds Stamp & File Number

4. Lot No. \_\_\_\_\_, Recorded Plat \_\_\_\_\_  
5. Private Claims \_\_\_\_\_

	A	B	C	D	E	F	G	H	I	J	K	L	M
2	6	5	4	3	2	1							
3													
4	7	8	9	10	11	12							
5													
6	18	17	16	15	14	13							
7													
8	19	20	21	22	23	24							
9													
10	30	29	28	27	26	25							
11													
12	31	32	33	34	35	36							
13													

I, William R. Byl, in a field survey on April 12, 1993, do hereby certify that under requirements of P.A. 74, Michigan P.A. of 1970, the corner points mentioned in lines 1 and 2 above were in conformance with regulations and rules therefore as required in the current manual of survey instructions of the United States Department of the Interior, Bureau of Land Management or by a decree of a Court of Law and/or that the corner points mentioned in lines 3, 4 and 5 above were in conformance with the rules of the Michigan Board of Land Surveyors or by a Decree of a Court of Law; established, re-established, monumented, re-monumented, recovered, found as expressed below:

**NOTE: Not more than 4 corners, all in the same town and range, may be recorded on this certificate.**

A. Description of original monument and accessories and/or subsequent restoration:

M-5	1831	GLO	Lyon	Set Post	P.A. 345 1990 KENT COUNTY
	1956	Williams & Works		City Iron	PEER APPROVED <u>11/17/94</u>
	1985	LCRC #4251	Byl	Set Kent County Monument	CHAIRMAN <u>Harry Stuber</u>

The position of this corner was previously approved by the Kent County Remonumentation Peer Group, monumented by William R. Byl on 6/10/85 and was recorded per LCRC #4251

B. Description of corner evidence found and/or method applied in restoring or reestablishing corner:

M-5 Found standard Kent Co. Mon. (Harrison) per witnesses from above LCRC as set by William R. Byl in place of the City Iron he found over top of a second City Iron. Both City Irons check with City of Grand Rapids and Williams & Works information.


LCRC #4251

NW cor. fdn. extension, Hse. #5	N30°E	110.43'
SE cor. brick veneer, Hse. #3	N00°E	73.71'
NW cor. fdn., at grade, Hse. #10	S60°E	95.70'
NE cor. fdn. of porch, Hse. #4	S20°W	37.92'
NE cor. brick planter, Hse. #8	S45°W	55.54'
Kent County Monument at SW cor. Sec. 7, T7N, R11W	N00°E	10.68'

The selected location is accepted by me and is generally accepted by professional surveyors as the best available evidence of the position of the original corner.

C. Description of monument for corner and accessories established to perpetuate locating the position of the corner:

M-5 Standard Kent County Monument		
NW cor. fdn. extension, Hse. #5	N30°E	110.43'
SE cor. brick veneer, Hse. #3	N00°E	73.73'
NW cor. fdn., at grade, Hse. #10	S60°E	95.70'
NE cor. fdn. of porch, Hse. #4	S20°W	37.92'
NE cor. brick planter, Hse. #8	S45°W	55.54'
Kent Co. Monument at SW cor. Sec. 7, T7N, R11W	N00°E	10.68'

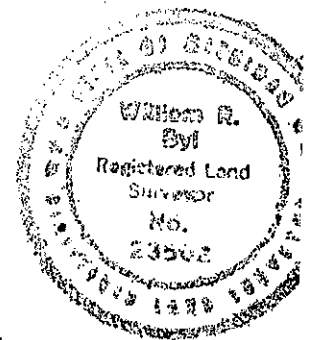

Signed by *William R. Byl* Date 11-17-94  
Surveyor's Michigan License No. 23502