

**SURVEY & REMONUMENTATION**

KENT COUNTY REMONUMENTATION

APR 28 1995

**LAND CORNER RECORDATION CERTIFICATE**  
Filing Requirement of Act 74, Mich. P.A. 1970

STATE OF MICHIGAN  
COUNTY OF KENT  
RECEIVED FOR RECORD  
94 NOV 28 AM 11:50

**COMMISSION**

For corners in  
KENT COUNTY

(County)	Located In:	Corner Code #
1. Public Land Survey	T 7N R 12W	M-6
	T R	
	T R	
	T R	
2. Property Controlling in Section	S T R	
	S T R	
3. Miscellaneous Property in Sec.	S T R	
	S T R	

*Luigi Bond*  
REG. OF DEEDS

**7378**

Register of Deeds Stamp & File Number

4. Lot No. \_\_\_\_\_, Recorded Plat \_\_\_\_\_  
5. Private Claims \_\_\_\_\_

	A	B	C	D	E	F	G	H	I	J	K	L	M
2	6	5	4	3	2	1							
3													
4	7	8	9	10	11	12							
5													
6	18	17	16	15	14	13							
7													
8	19	20	21	22	23	24							
9													
10	30	29	28	27	26	25							
11													
12	31	32	33	34	35	36							
13													

I, William R. Byl, in a field survey on April 12, 1993, do hereby certify that under requirements of P.A. 74, Michigan P.A. of 1970, the corner points mentioned in lines 1 and 2 above were in conformance with regulations and rules therefore as required in the current manual of survey instructions of the United States Department of the Interior, Bureau of Land Management or by a decree of a Court of Law and/or that the corner points mentioned in lines 3, 4 and 5 above were in conformance with the rules of the Michigan Board of Land Surveyors or by a Decree of a Court of Law; established, re-established, monumented, re-monumented, recovered, found as expressed below:

**NOTE: Not more than 4 corners, all in the same town and range, may be recorded on this certificate.**

**A. Description of original monument and accessories and/or subsequent restoration:**

M-6 1831 GLO Lyon Set Post  
City of Grand Rapids No desc. of corner-corner 4.01' North of W 1/4 cor. Sec. 18, T7N, R11W  
1985 LCRC #4252 Set Kent County Monument

The position of this corner was previously approved by the Kent County Remonumentation Peer Group, monumented by William R. Byl on 6/6/85 and was recorded per LCRC #4252

**B. Description of corner evidence found and/or method applied in restoring or reestablishing corner:**

M-6 Found standard Kent Co. Mon. (Harrison) per witnesses from above LCRC as set by William R. Byl on Twp. line 4.01' North of a City Iron he found at the W 1/4 cor. of Sec. 18, T7N, R11W. Said City Iron at W 1/4 Sec. 18, T7N, R11W checks with City of Grand Rapids information and adjoining plats.

LCRC #4252

C/L top of City Benchmark #106	S35°W	44.45'
C/L top of hydrant #6	N60°W	36.29'
SW cor. fdn. Hse. #5	N50°E	53.32'
NW cor. conc. block bldg. 0.2' above walk	S40°E	51.79'
Kent Co. Mon. at W 1/4 cor. Sec. 18, 7-11	S00°W	4.01'

The selected location is accepted by me and is generally accepted by professional surveyors as the best available evidence of the position of the original corner.


**C. Description of monument for corner and accessories established to perpetuate locating the position of the corner:**

M-6 Standard Kent County Monument  
C/L top of City Benchmark #106 S35°W 44.03'  
C/L top of hydrant #6 N60°W 36.29'  
SW cor. fdn. Hse. #5 N50°E 53.32'  
NW cor. conc. block bldg. 0.2' above walk S40°E 51.79'  
Kent Co. Mon. at W 1/4 cor. Sec. 18, 7-11 S00°W 4.01'

P.A. 345 1990 KENT COUNTY

PEER APPROVED 4/17/99

CHAIRMAN Harry Huber

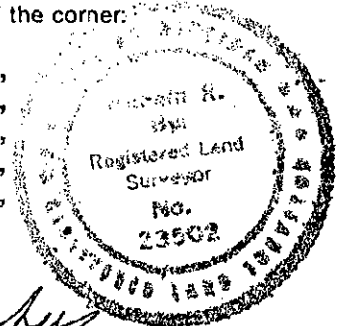

Signed by W. R. Byl Date 11-17-94  
Surveyor's Michigan License No. 23502