

APR 28 1995

KENT COUNTY REMONUMENTATION

STATE OF MICHIGAN  
COUNTY OF KENT  
RECEIVED FOR RECORD  
94 NOV 28 AM 11:51

COMMISSION

LAND CORNER RECORDATION CERTIFICATE  
Filing Requirement of Act 74, Mich. P.A. 1970

For corners in  
KENT COUNTY  
(County)

Located In:	Corner Code #
T 7N R 12W	M-8
T R	
T R	
T R	
T R	
S T R	
S T R	
S T R	
S T R	

*W. J. Land*  
REG. OF DEEDS

7380

Register of Deeds Stamp & File Number

- Public Land Survey
- Property Controlling in Section
- Miscellaneous Property in Sec.

- Lot No. \_\_\_\_\_, Recorded Plat \_\_\_\_\_
- Private Claims \_\_\_\_\_

I, William R. Byl, in a field survey on May 23, 19 94, do hereby certify that under requirements of P.A. 74, Michigan P.A. of 1970, the corner points mentioned in lines 1 and 2 above were in conformance with regulations and rules theretore as required in the current manual of survey instructions of the United States Department of the Interior, Bureau of Land Management or by a decree of a Court of Law and/or that the corner points mentioned in lines 3, 4 and 5 above were in conformance with the rules of the Michigan Board of Land Surveyors or by a Decree of a Court of Law; established, re-established, monumented, re-monumented, recovered, found as expressed below:

	A	B	C	D	E	F	G	H	I	J	K	L	M
2	6	5	4	3	2	1							
3													
4	7	8	9	10	11	12							
5													
6	18	17	16	15	14	13							
7													
8	19	20	21	22	23	24							
9													
10	30	29	28	27	26	25							
11													
12	31	32	33	34	35	36							
13													

NOTE: Not more than 4 corners, all in the same town and range, may be recorded on this certificate.

A. Description of original monument and accessories and/or subsequent restoration:

M-8	1831	GLO	Lyon	Set Post
	1871	City of Grand Rapids		Gov't. Post
	1985	LCRC #4253	Byl	Set Kent County Monument

The position of this corner was previously approved by the Kent County Remonumentation Peer Group, monumented by William R. Byl on 7/8/85 and was recorded per LCRC #4253

B. Description of corner evidence found and/or method applied in restoring or reestablishing corner:

M-8 Found standard Kent Co. Mon. (Harrison) per witnesses from above LCRC as set by William R. Byl. Said Kent Co. Mon. was set by proration of measurements of 1871 City of Grand Rapids survey of the West line of Sec. 19-7-11 on the extension of the line from the SW cor. of Sec. 19-7-11 through the W 1/4 cor. of Sec. 19-7-11.

LCRC #4253

Nail & tag W. sd. 6" Hickory	N20°E	28.04'
Nail & tag E. sd. 10" Hickory	N60°E	12.71'
Nail & tag E. sd. 10" Tw. Mulberry	S30°E	14.59'
Nail & tag E. sd. 8" Hickory	S25°W	28.47'
Kent Co. Mon. (A-8, T7N, R11W)	S00°W	11.88'

P.A. 345 1990 KENT COUNTY  
PEER APPROVED 11/17/94

CHAIRMAN *Harry Hubert*


The selected location is accepted by me and is generally accepted by professional surveyors as the best available evidence of the position of the original corner.

C. Description of monument for corner and accessories established to perpetuate locating the position of the corner:

M-8 Standard Kent County Monument

New Nail & KC Remon. tag W. sd. 10" Hickory	N20°E	27.66'
New Nail & KC Remon. tag E. sd. 12" Hickory	N60°E	12.75'
Nail & KC Remon. tag E. sd. 12" Tw. Mulberry	S30°E	14.59'
New Nail & KC Remon. tag E. sd. 10" Hickory	S25°W	28.47'
Kent Co. Mon. (A-8, T7N, R11W)	S00°W	11.88'

NOTE: CHECK WITNESSES BEFORE USING, MONUMENT ON SIDE OF STEEP HILL

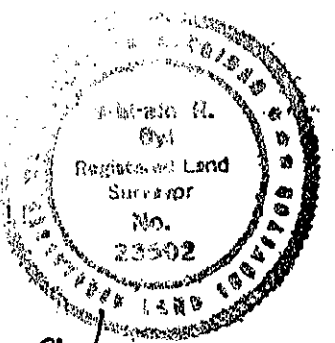

Signed by *W. R. Byl*  
Surveyor's Michigan License No. 23502

Date 11-17-94