

SURVEY & REMONUMENTATION

APR 28 1995

COMMISSION

KENT COUNTY REMONUMENTATION

LAND CORNER RECORDATION CERTIFICATE
Filing Requirement of Act 74, Mich. P.A. 1970

STATE OF MICHIGAN
COUNTY OF KENT
RECEIVED FOR RECORD

94 NOV 28 AM 11:51

For corners in
KENT COUNTY

(County)

Located In:

Corner Code #

1. Public Land Survey	T	7N	R	12W	M-11
	T	7N	R	11W	A-11
	T		R		
	T		R		
2. Property Controlling in Section	S		T	R	
	S		T	R	
3. Miscellaneous Property in Sec.	S		T	R	
	S		T	R	

W. R. Byl
REG. OF DEEDS

7383

Register of Deeds Stamp & File Number

4. Lot No. _____, Recorded Plat _____
5. Private Claims _____

I, William R. Byl, in a field survey on June 3, 19 94, do hereby certify that under requirements of P.A. 74, Michigan P.A. of 1970, the corner points mentioned in lines 1 and 2 above were in conformance with regulations and rules therefore as required in the current manual of survey instructions of the United States Department of the Interior, Bureau of Land Management or by a decree of a Court of Law and/or that the corner points mentioned in lines 3, 4 and 5 above were in conformance with the rules of the Michigan Board of Land Surveyors or by a Decree of a Court of Law; established, re-established, monumented, re-monumented, recovered, found as expressed below:

NOTE: Not more than 4 corners, all in the same town and range, may be recorded on this certificate.

A	B	C	D	E	F	G	H	I	J	K	L	M
2	6	5	4	3	2	1						
3												
4	7	8	9	10	11	12						
5												
6	13	17	16	15	14	13						
7												
8	19	20	21	22	23	24						
9												
10	30	29	28	27	26	25						
11												
12	31	32	33	34	35	36						
13												

A. Description of original monument and accessories and/or subsequent restoration:

M-11	1831	GLO	Lyon	Set Post
	1938	City of Grand Rapids	E.H. Christ	City Iron
	1985	LCRC #4281	Byl	Set Kent County Monument

P.A. 345 1990 KENT COUNTY
PEER APPROVED 11/17/94
CHAIRMAN Harry Harker
"Doran's Assess. Plat No. 2"
Set Kent County Monument

The position of this corner was previously approved by the Kent County Remonumentation Peer Group, monumented by William R. Byl on 5/29/85 and was recorded per LCRC #4281

B. Description of corner evidence found and/or method applied in restoring or reestablishing corner:

M-11 Found PK Nail (Kent Co. Mon. removed during road const. after 1985) per witnesses from above LCRC. In 1985 William R. Byl established the location of this corner from the field notes of E.H. Christ. Said location checks with remaining witnesses from City of Grand Rapids.


LCRC #4281

"V" cut in SE cor. of base of post	N45°W	47.22'
"V" cut in face of concrete street light pole	N60°E	53.92'
"+" cut in top of NW bolt of traffic signal pole base	S70°E	79.93'
SW cor. of brick veneer of building @ walk grade	S35°E	83.62'
Face of hydrant jacket @ walk grade	S25°W	56.45'

The selected location is accepted by me and is generally accepted by professional surveyors as the best available evidence of the position of the original corner.

C. Description of monument for corner and accessories established to perpetuate locating the position of the corner:

M-11 Set Standard Kent County Monument in place of PK Nail		
"V" cut in SE cor. of base of post	N45°W	47.24'
Face of concrete street light pole (new location)	N60°E	61.55'
"+" cut in top of NW bolt of traffic signal pole base	S70°E	79.93'
SW cor. of brick veneer of building @ walk grade	S35°E	83.65'
Face of hydrant jacket @ walk grade	S25°W	56.71'

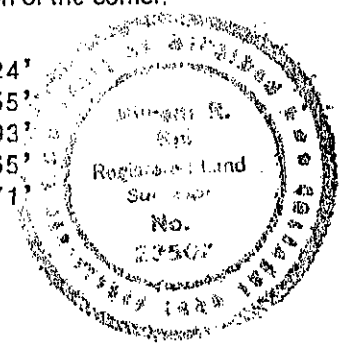

Signed by W. R. Byl Date 11-17-94
Surveyor's Michigan License No. 23502