

**COMMISSION**

**LAND CORNER RECORDATION CERTIFICATE**

Filing Requirement of Act 74, Mich. P.A. 1970

NOV 28 AM 11:51

For corners in  
 KENT COUNTY  
 (County)

Located In:	Corner Code #
T 7N R 12W	M-12
T 7N R 11W	A-12
T R	
T R	
S T R	
S T R	
S T R	
S T R	

*W. J. Bond*  
 REG. OF DEEDS

7384

Register of Deeds Stamp & File Number

- Public Land Survey
- Property Controlling in Section
- Miscellaneous Property in Sec.

- Lot No. \_\_\_\_\_, Recorded Plat \_\_\_\_\_
- Private Claims \_\_\_\_\_

	A	B	C	D	E	F	G	H	I	J	K	L	M
2	6	5	4	3	2	1							
3													
4	7	8	9	10	11	12							
5													
6	18	17	16	15	14	13							
7													
8	19	20	21	22	23	24							
9													
10	30	29	28	27	26	25							
11													
12	31	32	33	34	35	36							
13													

I, William R. Byl, in a field survey on June 3, 19 94, do hereby certify that under requirements of P.A. 74, Michigan P.A. of 1970, the corner points mentioned in lines 1 and 2 above were in conformance with regulations and rules therefore as required in the current manual of survey instructions of the United States Department of the Interior, Bureau of Land Management or by a decree of a Court of Law and/or that the corner points mentioned in lines 3, 4 and 5 above were in conformance with the rules of the Michigan Board of Land Surveyors or by a Decree of a Court of Law; established, re-established, monumented, re-monumented, recovered, found as expressed below:

**NOTE: Not more than 4 corners, all in the same town and range, may be recorded on this certificate.**

A. Description of original monument and accessories and/or subsequent restoration:

M-12 1831 GLO	Lyon	Set Post
1900-1980 Williams & Works	E.H. Christ	Copper Spike
1938	Byl	Corner shown on
1985 LCRC #5100		"Doran's Assess. Plat No. 15"
		Set Kent County Monument

P.A. 345 1990 KENT COUNTY  
 PEER APPROVED 11/17/94  
 CHAIRMAN *Harry Huber*

The position of this corner was previously approved by the Kent County Remonumentation Peer Group, monumented by William R. Byl on 4/17/85 and was recorded per LCRC #5100

B. Description of corner evidence found and/or method applied in restoring or reestablishing corner:

M-12 Found BROKEN standard Kent Co. Mon. (Harrison) per witnesses from above LCRC as set by William R. Byl in place of a PK Nail he found. Said PK Nail checks with dimensions as shown in "Doran's Assess. Plat No. 15." Byl also found a Mon. Box 15" below PK Nail during installation of Kent Co. Mon.


LCRC #5100

"V" cut in face of light pole	N45°E	55.44'
"V" cut in middle corner of bldg. fdn.	S45°E	61.81'
SE cor. of crossing signal base	N45°W	50.70'
Capped iron in lawn	S55°W	66.19'

The selected location is accepted by me and is generally accepted by professional surveyors as the best available evidence of the position of the original corner.

C. Description of monument for corner and accessories established to perpetuate locating the position of the corner:

M-12 Set Standard Kent County Monument in place of broken Kent Co. Mon.  
 "V" cut in middle corner of bldg. fdn. S45°E 61.81'  
 SE cor. of crossing signal base N45°W 50.70'  
 Capped iron in lawn S55°W 66.19'  
 SW face of crossing signal post N50°E 55.87'

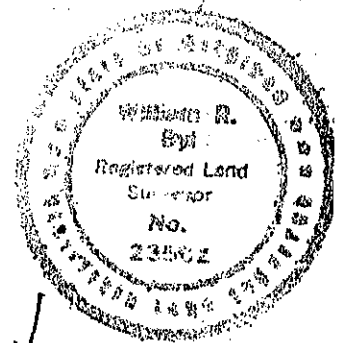

Signed by *W. R. Byl*  
 Surveyor's Michigan License No. 23502

Date 11-17-94