


GOVERNMENT SURVEY CORNER NUMBERING CODE DIAGRAM

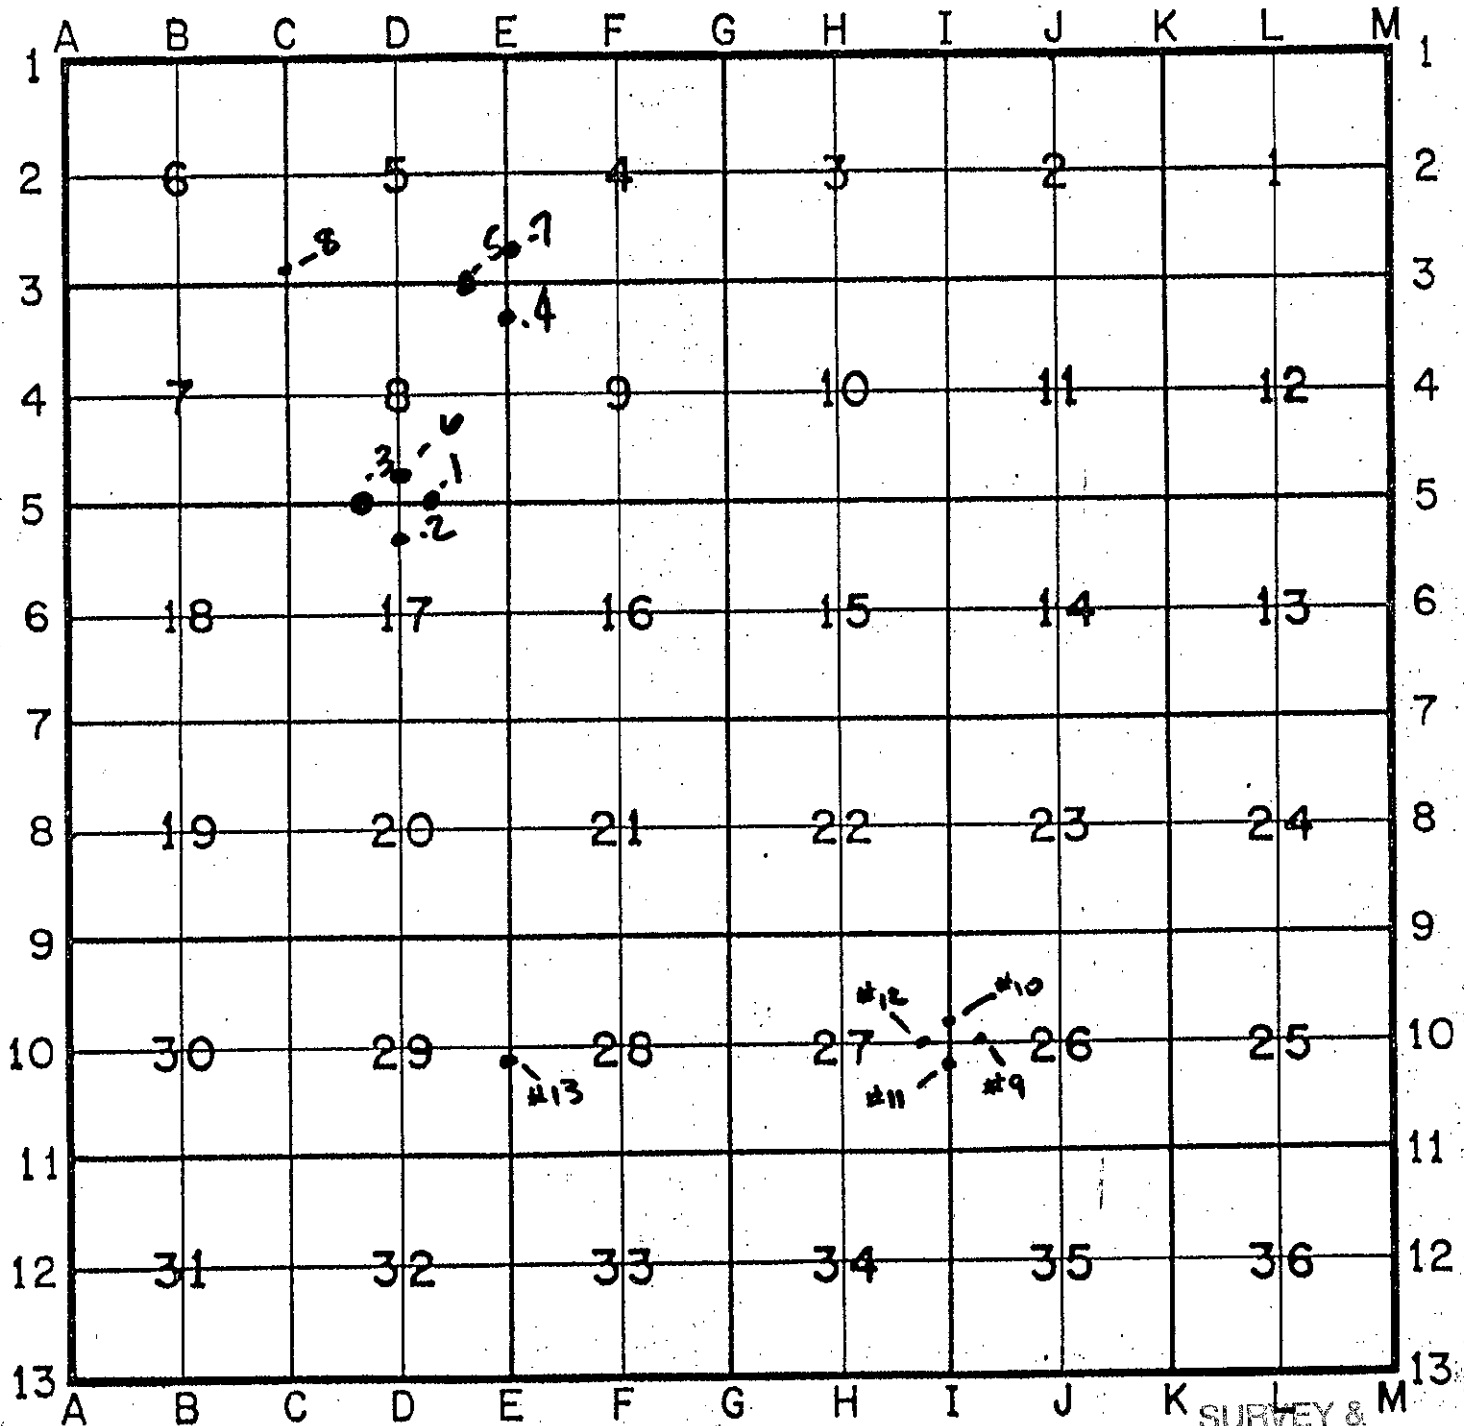

SURVEY & M
REMONUMENTATION

MAR 01 1999

SECTION

Kent Co. T8N R9W
Grattan Twp