

SURVEY & REMONUMENTATION

MAR 03 1998

LAND CORNER RECORDATION CERTIFICATE
 Filing Requirement of Act 74, Mich. P.A. 1970
 KENT COUNTY REMONUMENTATION

\$7.00
 \$2.00
 For corners in

SECTION


STATE OF MICHIGAN
 COUNTY OF KENT
 RECEIVED FOR RECORD
 97 NOV 14 AM 9:00
 REG. OF DEEDS
Lucy Standa

Kent (County)	Located in: Grattan Township	Corner Code #
1. Public Land Survey	T <u>8N</u> R <u>9W</u>	<u>A-2</u>
	T _____ R _____	_____
	T _____ R _____	_____
	T _____ R _____	_____
2. Property Controlling in Section	S _____ T _____ R _____	_____
	S _____ T _____ R _____	_____
3. Miscellaneous Property in Sec.	S _____ T _____ R _____	_____
	S _____ T _____ R _____	_____
4. Lot No. _____, Recorded Plat _____		
5. Private Claims _____		

10296

Register of Deeds Stamp & File Number

I, Randy Kolehouse, in a field survey on July 1 19 97, do hereby certify that under requirements of P.A. 74 Michigan P.A. of 1970, the corner points mentioned in lines 1 and 2 above were in conformance with regulations and rules therefore as required in the current manual of survey instructions of the United States Department of the Interior, Bureau of Land Management or by a decree of a Court of Law and/or that the corner points mentioned in lines 3, 4 and 5 above were in conformance with the rules of the Michigan Board of Land Surveyors or by a Decree of a Court of Law; established, re-established, monumented, re-monumented, recovered, found as expressed below:

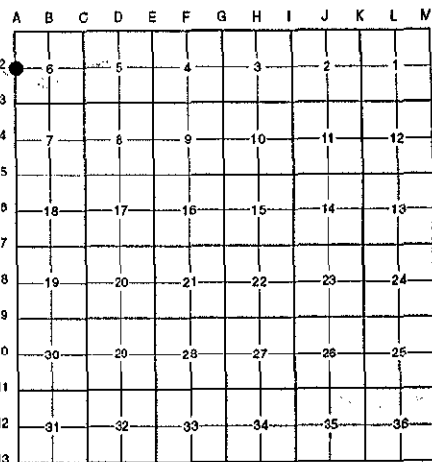

NOTE: Not more than 4 corners, all in the same town and range, may be recorded on this certificate.

A. Description of original monument and accessories and/or subsequent restoration:

A-2	1831	G.L.O. Notes	Mullett	Set Post	P.A. 345 1990 KENT COUNTY
	N/A	Witness Map	K.C. Surveyor	Iron	PEER APPROVED <u>8/28/97</u>
	1978	L.C.R.C. #1121	Williams & Works	3/4" Iron	CHAIRMAN <u>Randy Kolehouse</u>
	1979	L.C.R.C. #1295	Exxel Engineering	Iron (M-2, T8N, R10W)	
	1981	L.C.R.C. #1899	Jonker Land Surveys	Fnd. 3/4" Round Iron / Set K.C. Monument (M-w, T8N, R10W)	
	1989	L.C.R.C. #5287	J. Bueche	K.C. Monument (M-2, T8N, R10W)	

Note: This corner is common with M-2, T8N, R10W.

This corner was originally approved by the Kent County Remonumentation Peer Group and monumented by Rob Jonker on 7/15/81 and was recorded per L.C.R.C. #1899.

B. Description of corner evidence found and/or method applied in restoring or reestablishing corner:

A-2 Found a Standard Kent County Monument 10' West of the C/L of Tiffany Avenue (gravel) running North and South per L.C.R.C.'s #1899 and #5287 as set by Rob Jonker in place of a 3/4" round iron he found which checked L.C.R.C.'s #1295, #1121, and the K.C. Surveyor's records.

L.C.R.C. #1899

L.C.R.C. #5287

Remon. tag on SW side 28" Oak N 54° W 41.35'
 Remon. tag on SW side 28" Oak N 36° W 56.60'
 Remon. tag on S. side T. pole S 76° E 40.46'
 Remon. tag on N. side 48" Willow S 71° W 63.02'


Remon. tag & nail on SW side 32" Oak N 54° W 41.20'
 Remon. tag & nail on SW side 32" Oak N 36° W 56.34'
 Remon. tag & nail on S side T. pole S 76° E 40.46'
 Remon. tag & nail on N side 54" Willow S 71° W 62.93'

The selected location is accepted by me and is generally accepted by professional surveyors as the best available evidence of the position of the original corner.

C. Description of monument for corner and accessories established to perpetuate locating the position of the corner:

A-2 Standard Kent County Monument

Nail & K.C. remon. tag on SW side 32" Oak N 54° W 41.20'
 Nail & K.C. remon. tag on SW side 32" Oak N 36° W 56.34'
 Nail & K.C. remon. tag on S side T. pole S 76° E 40.46'
 Nail & K.C. remon. tag on N side 54" Willow S 71° W 62.93'

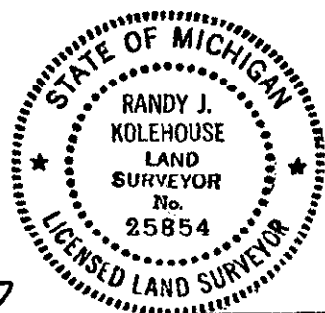

Signed by Randy J. Kolehouse Date 9/23/97
 EARTH TECH

Surveyor's Michigan License No. 25854